TENNESSEE D.O.T.
DESIGN DIVISION
FILE NO.

TYPE	YEAR	PROJECT NO.	SHEET NO.
CONST.	2020	68001-3251-14	U2-9

S.R. 13 PERRY CO.

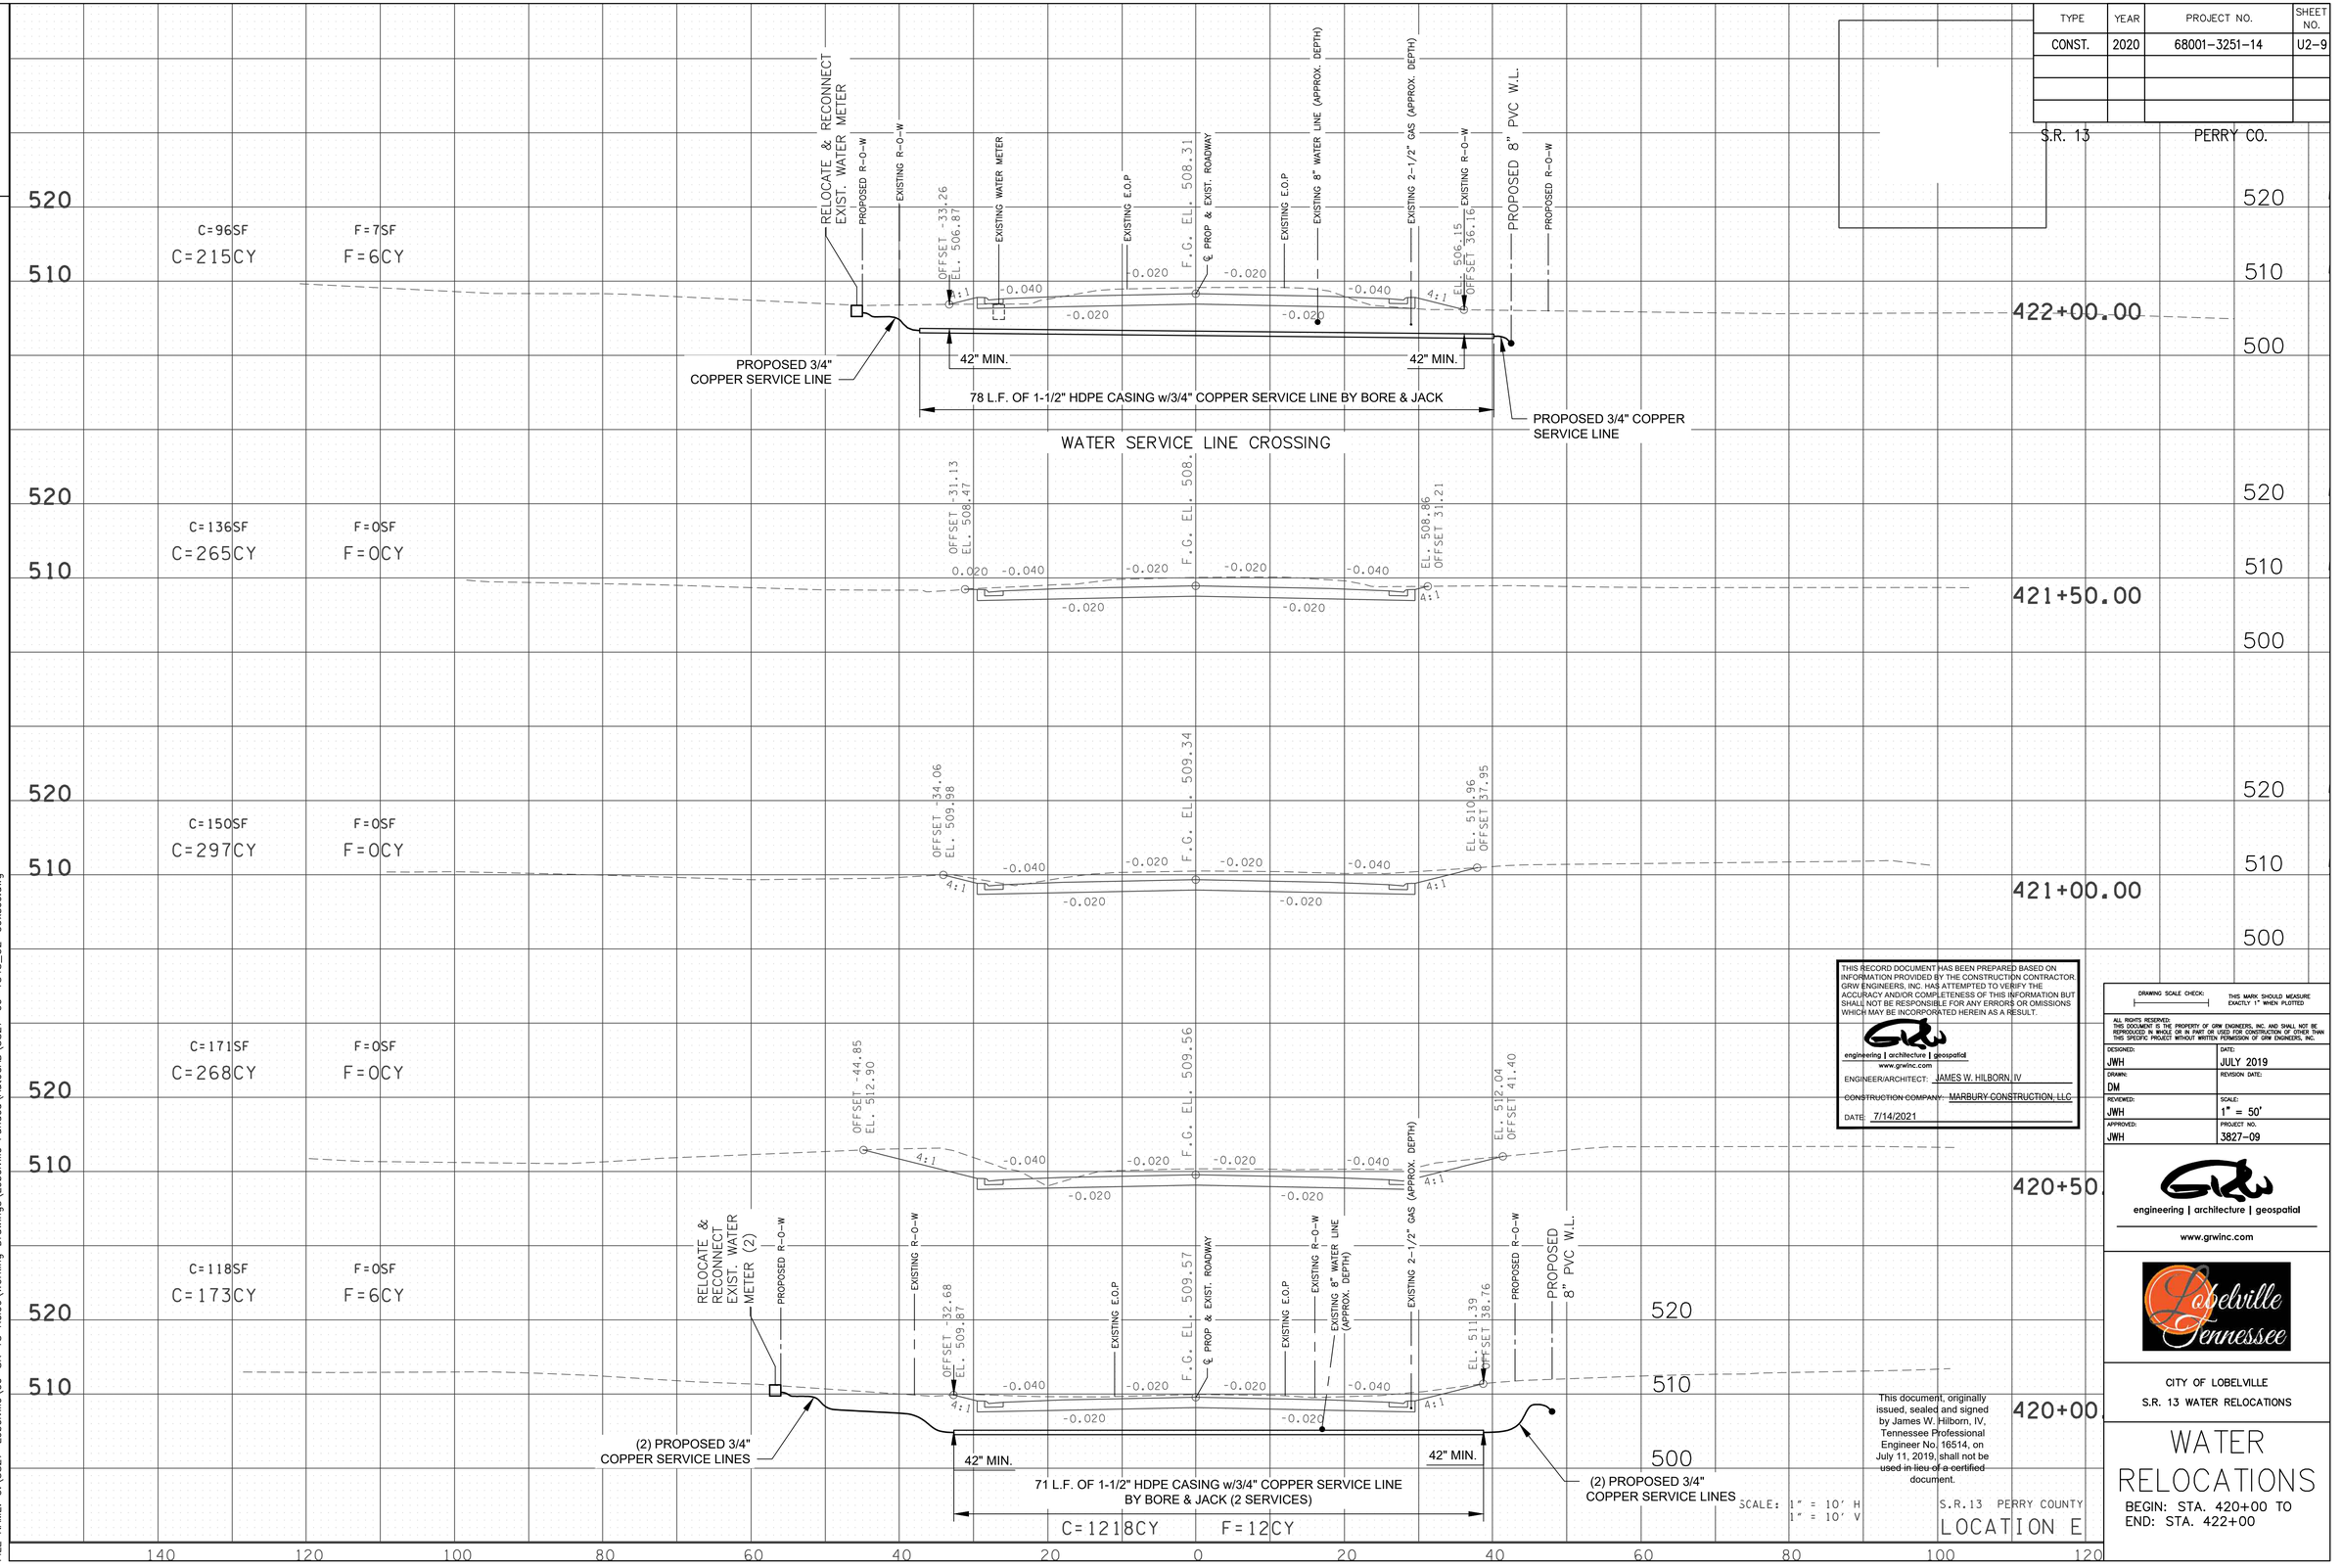

THIS RECORD DOCUMENT HAS BEEN PREPARED BASED ON INFORMATION PROVIDED BY THE CONSTRUCTION CONTRACTOR. GRW ENGINEERS, INC. HAS ATTEMPTED TO VERIFY THE ACCURACY AND/OR COMPLETENESS OF THIS INFORMATION BUT SHALL NOT BE RESPONSIBLE FOR ANY ERRORS OR OMISSIONS WHICH MAY BE INCORPORATED HEREIN AS A RESULT.

engineering | architecture | geospatial
www.grwinc.com

ENGINEER/ARCHITECT: JAMES W. HILBORN, IV

~~CONSTRUCTION COMPANY: MARBURY CONSTRUCTION, LLC~~

DATE: 7/14/2021

DRAWING SCALE CHECK: THIS MARK SHOULD MEASURE EXACTLY 1" WHEN PLOTTED

ALL RIGHTS RESERVED:
THIS DOCUMENT IS THE PROPERTY OF GRW ENGINEERS, INC. AND SHALL NOT BE REPRODUCED IN WHOLE OR IN PART OR USED FOR CONSTRUCTION OF OTHER THAN THIS SPECIFIC PROJECT WITHOUT WRITTEN PERMISSION OF GRW ENGINEERS, INC.

DESIGNED: JWH	DATE: JULY 2019
DRAWN: DM	REVISION DATE:
REVIEWED: JWH	SCALE: 1" = 50'
APPROVED: JWH	PROJECT NO. 3827-09

engineering | architecture | geospatial
www.grwinc.com

Lobelville Tennessee

CITY OF LOBELVILLE
S.R. 13 WATER RELOCATIONS

WATER RELOCATIONS

BEGIN: STA. 420+00 TO
END: STA. 422+00

This document, originally issued, sealed and signed by James W. Hilborn, IV, Tennessee Professional Engineer No. 16514, on July 11, 2019, shall not be used in lieu of a certified document.

SCALE: 1" = 10' H
1" = 10' V

S.R.13 PERRY COUNTY
LOCATION E

PRINTED: 7/15/2021 @ 7:46AM
FILE NAME: G:\3827-Lobelville\09-SR 13 Reloc\Working Drawings\Lobelville Funded\AutoCAD\3827-09-1345_U2-09xsec.dwg