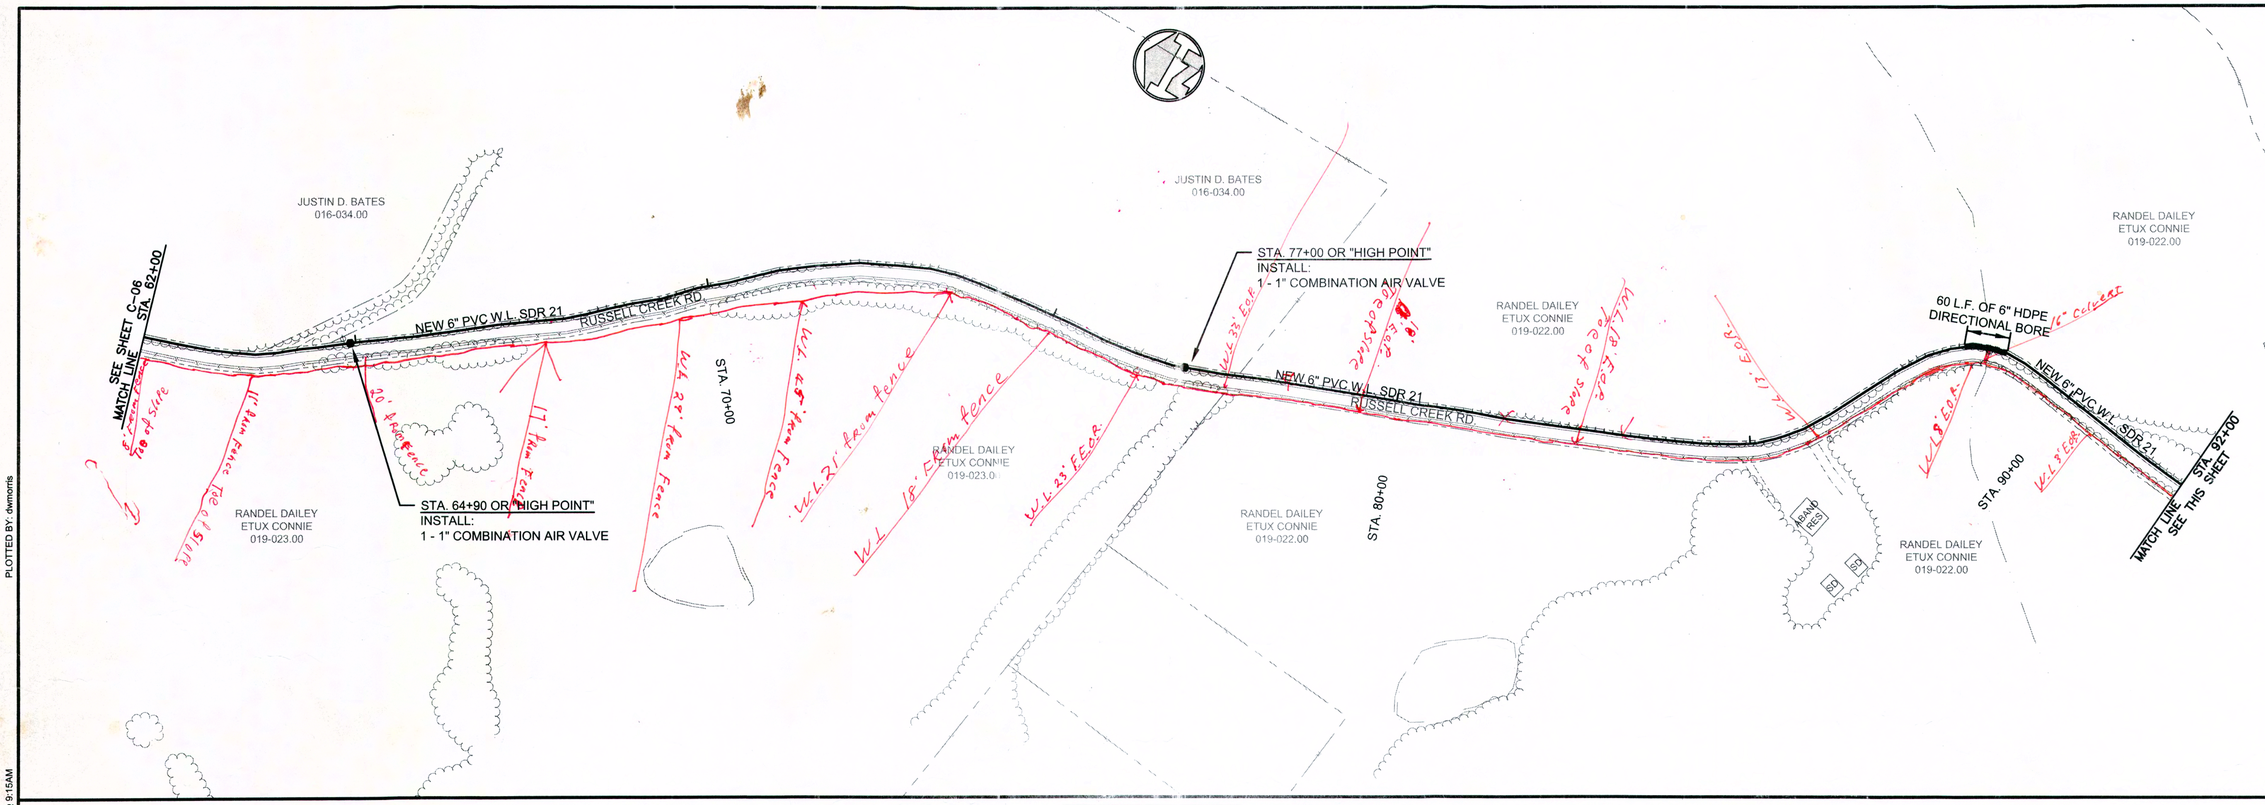

GRAPHIC SCALE
0 50 100 200
1 inch = 100 feet

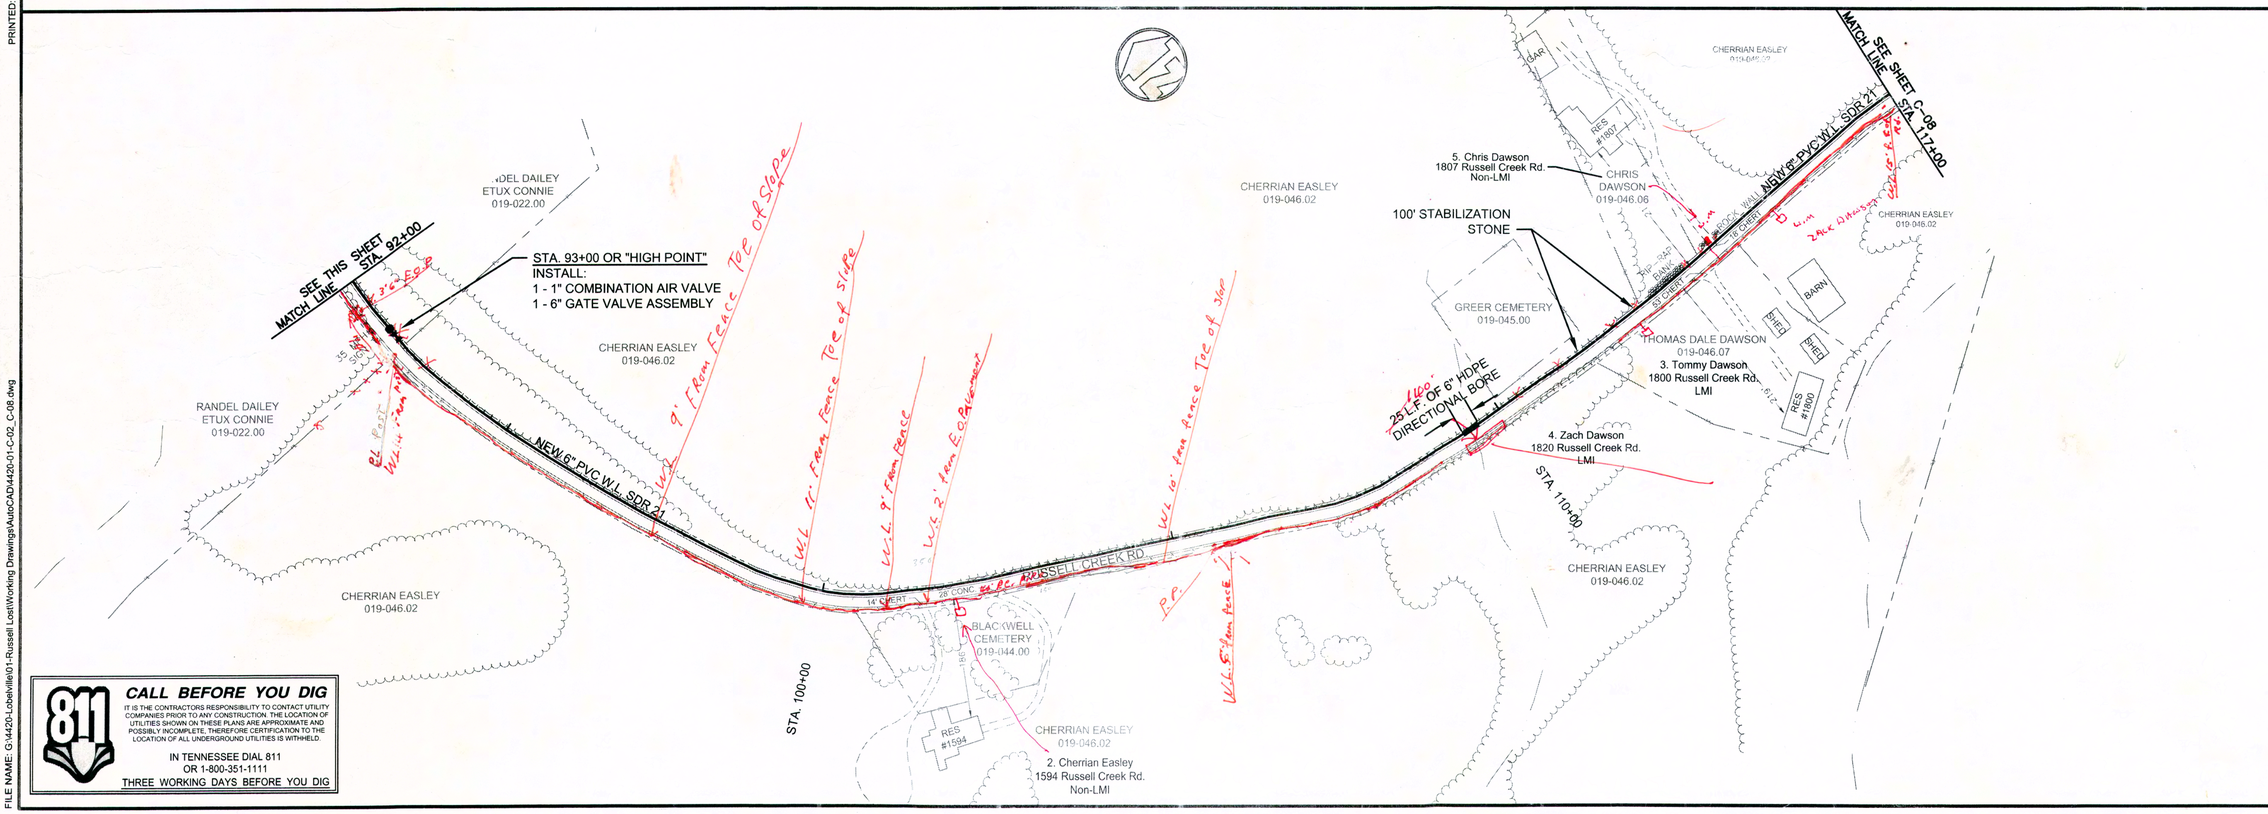

CALL BEFORE YOU DIG

IT IS THE CONTRACTORS RESPONSIBILITY TO CONTACT UTILITY COMPANIES PRIOR TO ANY CONSTRUCTION. THE LOCATION OF UTILITIES SHOWN ON THESE PLANS ARE APPROXIMATE AND POSSIBLY INCOMPLETE. THEREFORE CERTIFICATION TO THE LOCATION OF ALL UNDERGROUND UTILITIES IS WITHHELD.

IN TENNESSEE DIAL 811
OR 1-800-351-1111
THREE WORKING DAYS BEFORE YOU DIG

BARRY L. CLOUD
REGISTERED ENGINEER
AGRICULTURE
No. 100993
STATE OF TENNESSEE

GRW PROJECT NO. 4420-01

ALL RIGHTS RESERVED
THIS DOCUMENT IS THE PROPERTY OF GRW ENGINEERS, INC. AND SHALL NOT BE REPRODUCED IN WHOLE OR IN PART OR USED IN ANY WAY ON ANY OTHER PROJECT OR USED ON THIS PROJECT WITHOUT WRITTEN PERMISSION

GRW
engineering | architecture | geospatial
www.grwinc.com

CONTRACT DRAWINGS

LINE "B" - STA. 62+00 TO STA. 117+00

LOST CREEK RD. & RUSSELL CREEK RD. WATER LINES
CITY OF LOBELVILLE, TENNESSEE

DESIGNED:	BLC
DRAWN:	DMLEN
REVIEWED:	BLC
APPROVED:	BLC

REVISIONS

NO.	DESCRIPTION	DATE	BY
1	ADDED LMI / NON-LMI RESIDENCES	2/17/16	DM

THIS MARK SHOULD MEASURE EXACTLY 1" WHEN PLOTTED

DATE: OCTOBER '
SCALE: 1" = 100'
SHEET NO.

PLOTTED BY: dwnorris
PRINTED: 3/15/2016 @ 9:15AM
FILE NAME: G:\4420-Lobelville\01-Russell Lost\Working Drawings\AutoCAD\4420-01-C-02_C-08.dwg