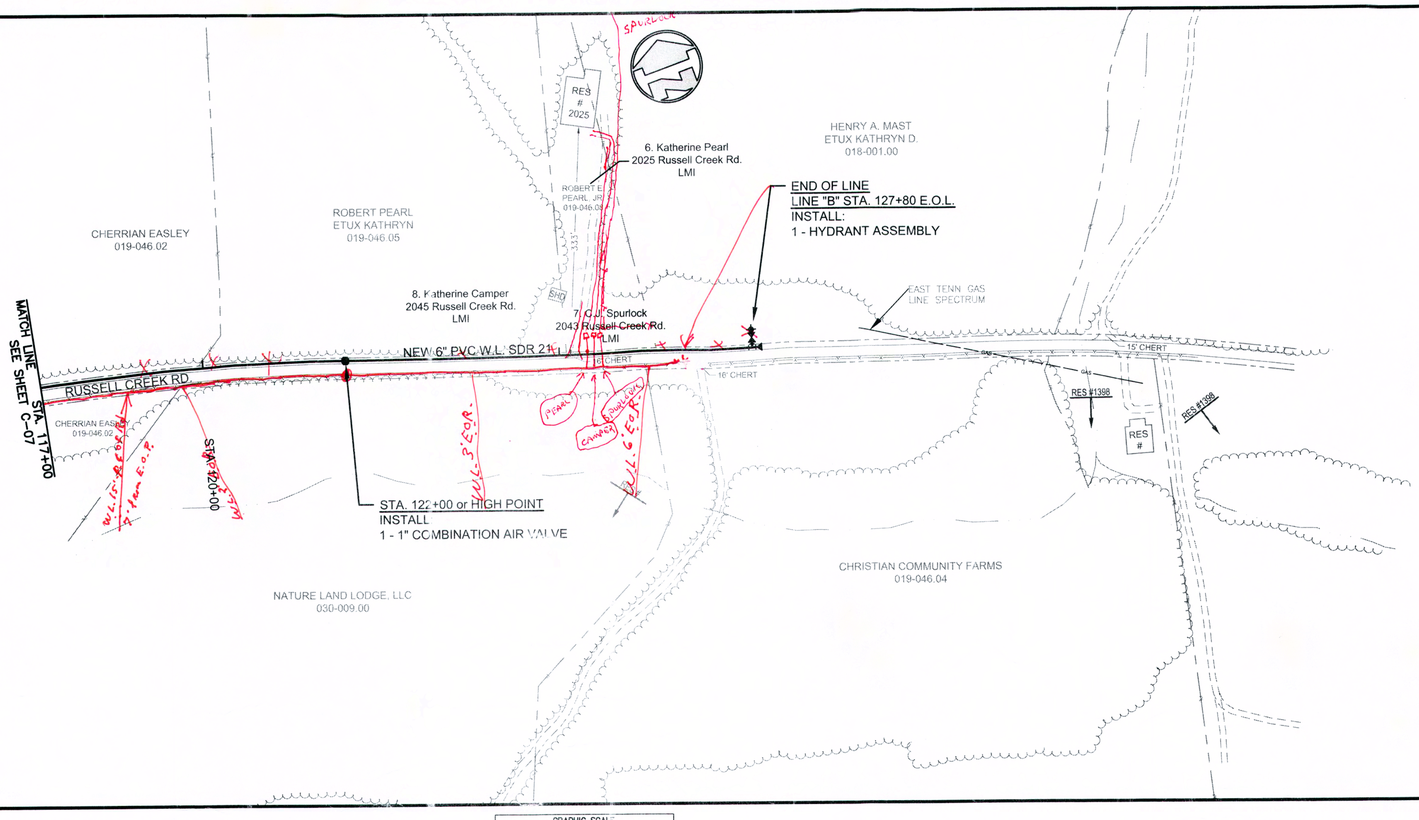

GRAPHIC SCALE
0 50 100 200
1 inch = 100 feet

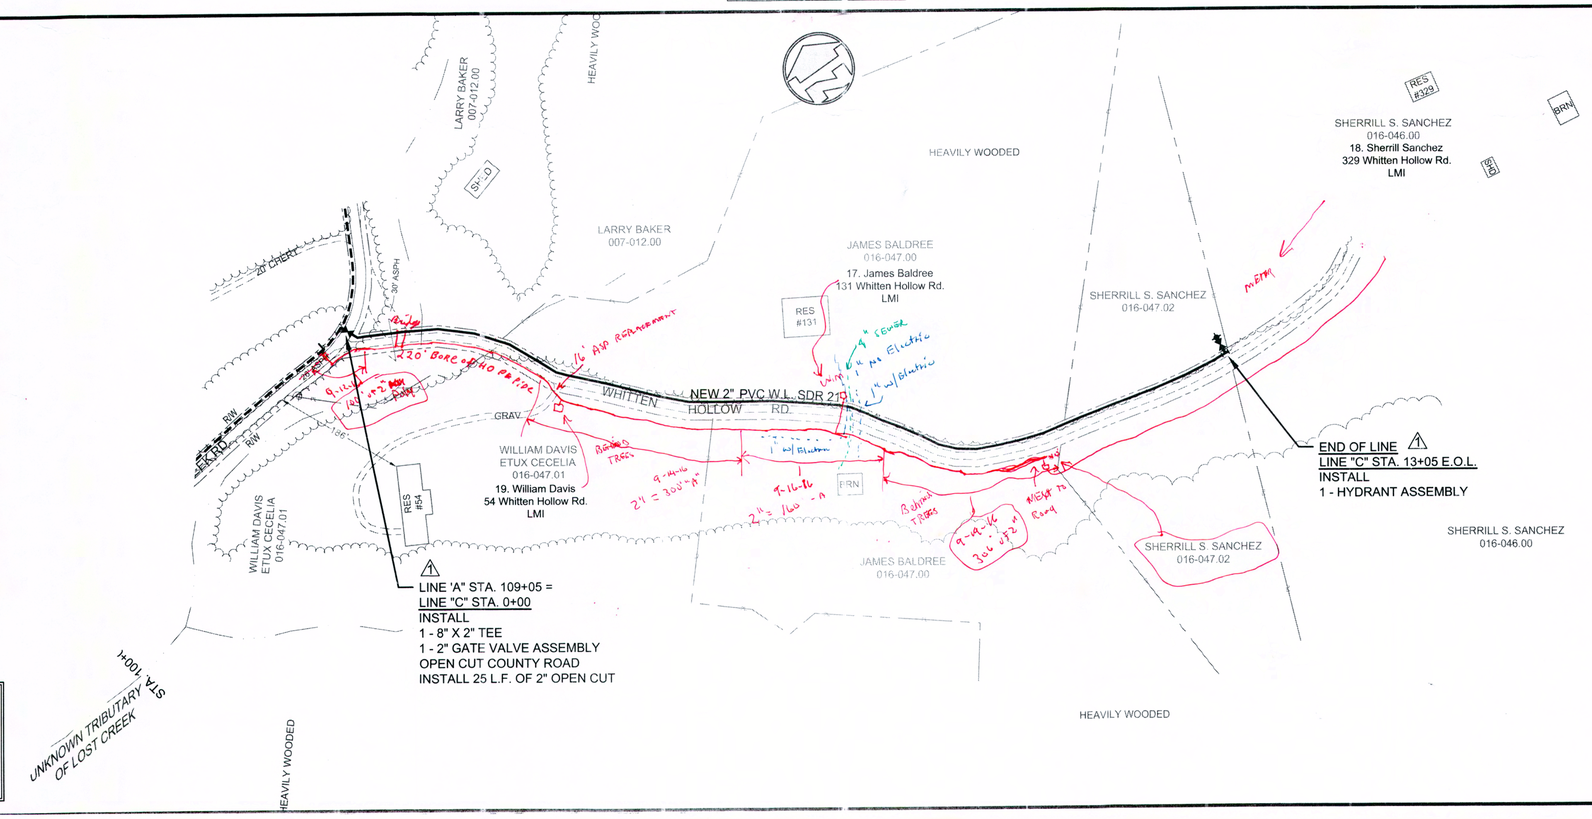

CALL BEFORE YOU DIG

IT IS THE CONTRACTORS RESPONSIBILITY TO CONTACT UTILITY COMPANIES PRIOR TO ANY CONSTRUCTION. THE LOCATION OF UTILITIES SHOWN ON THESE PLANS ARE APPROXIMATE AND POSSIBLY INCOMPLETE. THEREFORE CERTIFICATION TO THE LOCATION OF ALL UNDERGROUND UTILITIES IS WITHHELD.

IN TENNESSEE DIAL 811
OR 1-800-351-1111
THREE WORKING DAYS BEFORE YOU DIG

BARRY L. CLOYD
REGISTERED ENGINEER
100891
STATE OF TENNESSEE
2/17/16

CONTRACT DRAWINGS

GRW PROJECT NO. 4420-01

ALL RIGHTS RESERVED
THIS DOCUMENT IS THE PROPERTY OF GRW ENGINEERS, INC. AND SHALL NOT BE REPRODUCED IN WHOLE OR IN PART OR USED FOR ANY PURPOSE OR PROJECT OTHER THAN THIS SPECIFIC PROJECT WITHOUT WRITTEN PERMISSION

engineering | architecture | geospatial
www.grwinc.com

LINE "B" -STA. 117+00 TO STA. 127+80 E.O.L.
LINE "C" - STA. 0+00 TO STA. 13+05 E.O.L.

LOST CREEK RD. & RUSSELL CREEK RD. WATER LINES
CITY OF LOBELVILLE, TENNESSEE

DESIGNED	DRAWN	REVIEWED	APPROVED
BLC	DM/LEN	BLC	BLC

REVISIONS

NO.	DESCRIPTION	DATE	BY
1	ADDED WHITTEN HOLLOW RD. LINE "C"	2/17/16	DM
	ADDED LMI / NON-LMI RESIDENCES		

THIS MARK SHOULD MEASURE EXACTLY 1" WHEN PLOTTED
SCALE CHECK:

DATE:
OCTOBER 2015

SCALE:
1" = 100'

SHEET NO.
C-08

PLOTTED BY: dwmorris
PRINTED: 3/15/2016 @ 9:16AM
FILE NAME: G:\4420-Lobelville\01-Russell Lost\Working Drawings\AutoCAD\4420-01-C-02_C-08.dwg