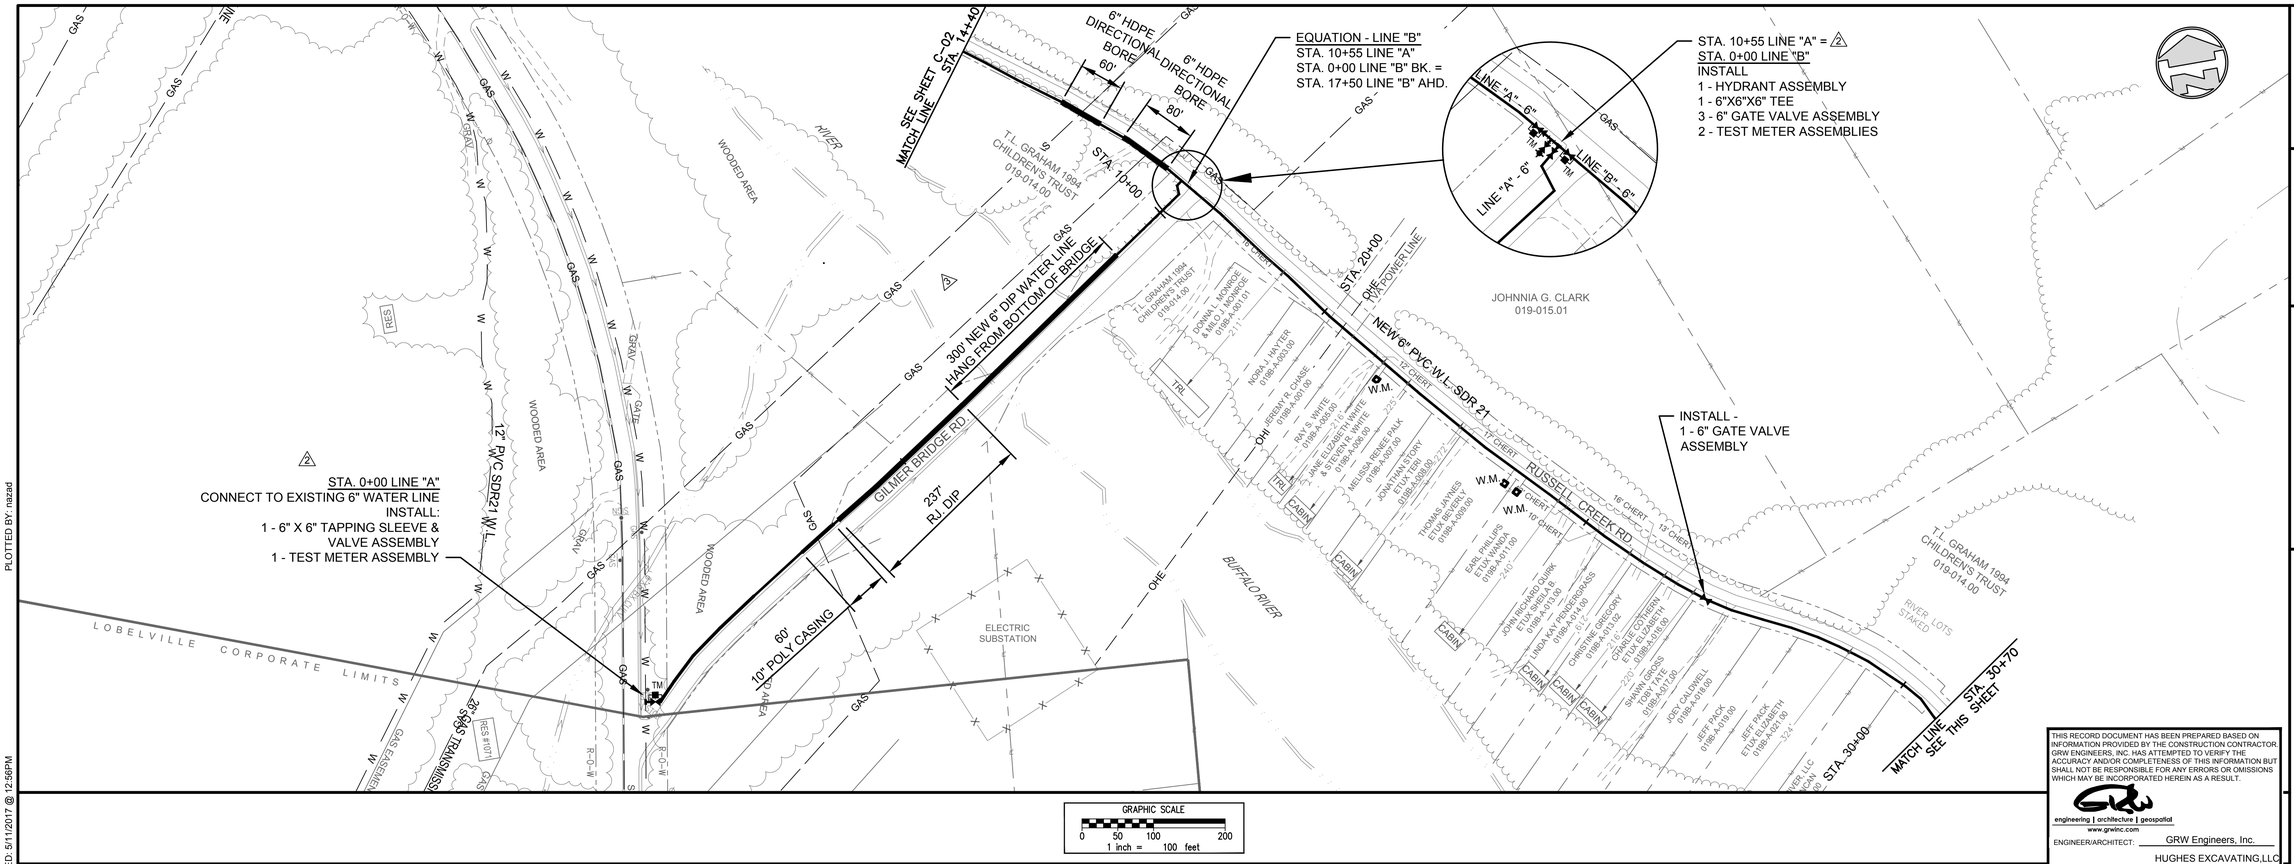

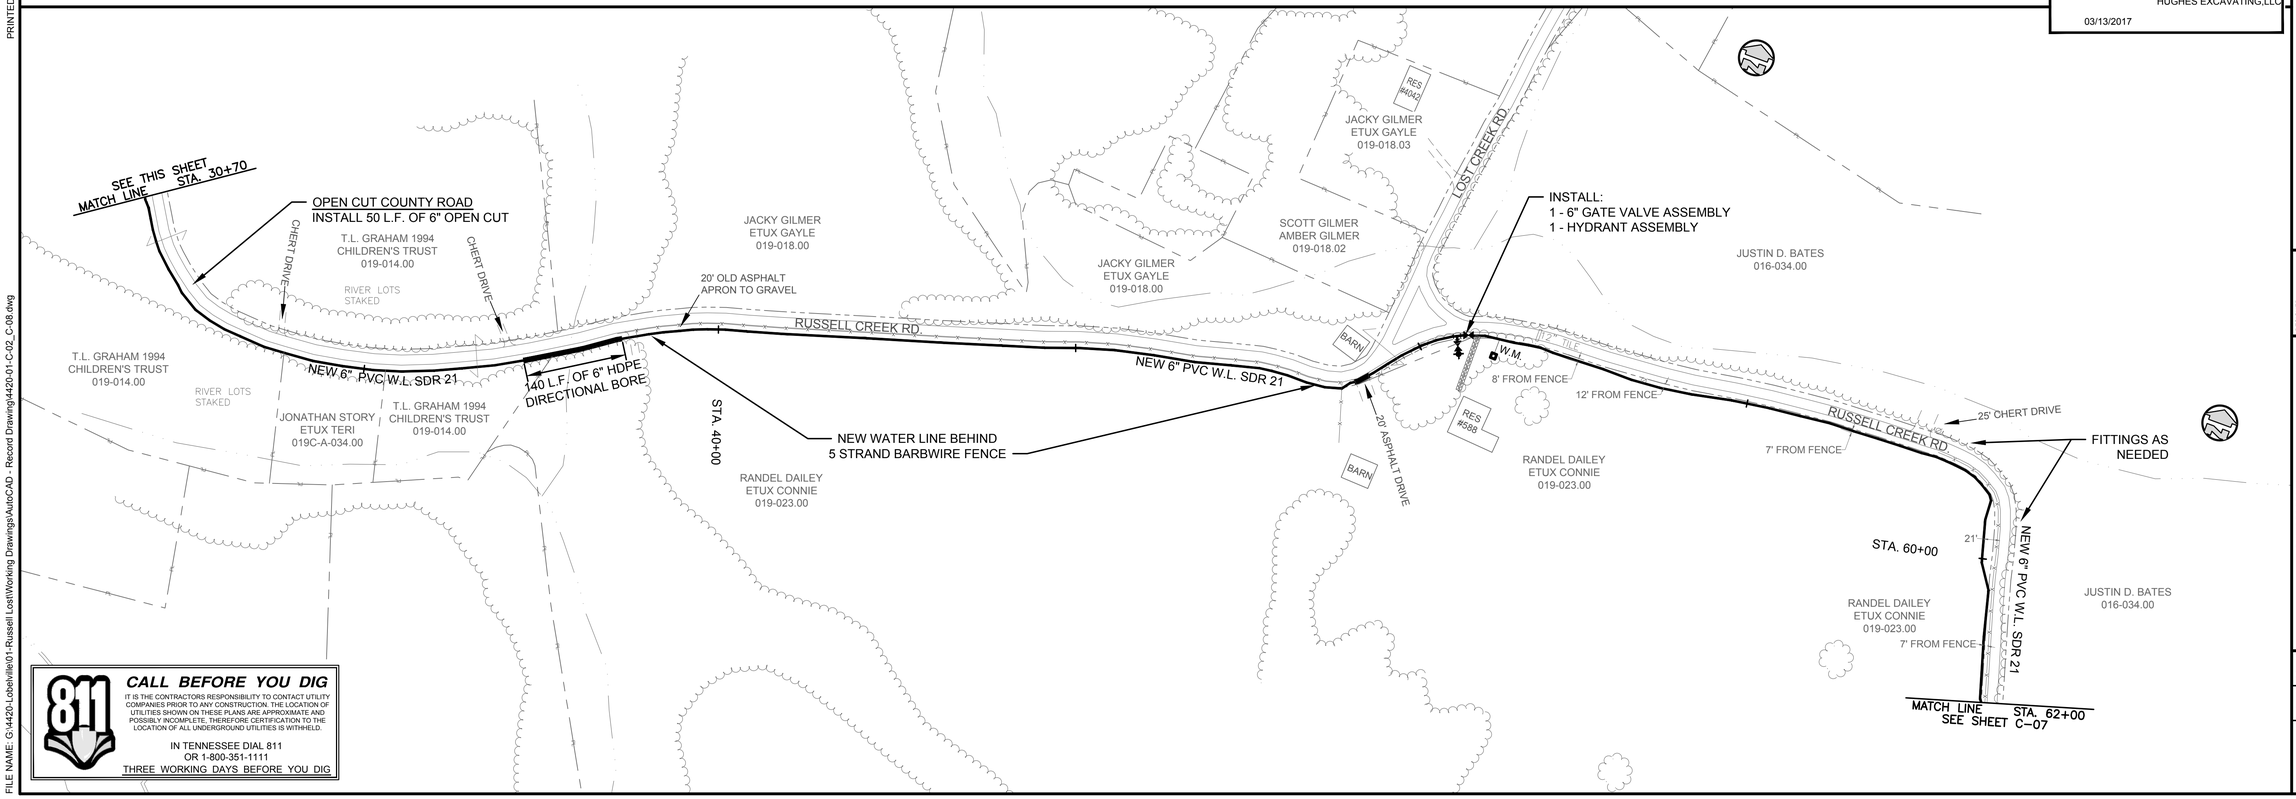

CALL BEFORE YOU DIG

IT IS THE CONTRACTORS RESPONSIBILITY TO CONTACT UTILITY COMPANIES PRIOR TO ANY CONSTRUCTION. THE LOCATION OF UTILITIES SHOWN ON THESE PLANS ARE APPROXIMATE AND POSSIBLY INCOMPLETE. THEREFORE CERTIFICATION TO THE LOCATION OF ALL UNDERGROUND UTILITIES IS WITHHELD.

IN TENNESSEE DIAL 811
OR 1-800-351-1111
THREE WORKING DAYS BEFORE YOU DIG

THIS RECORD DOCUMENT HAS BEEN PREPARED BASED ON INFORMATION PROVIDED BY THE CONSTRUCTION CONTRACTOR. GRW ENGINEERS, INC. HAS ATTEMPTED TO VERIFY THE ACCURACY AND/OR COMPLETENESS OF THIS INFORMATION BUT SHALL NOT BE RESPONSIBLE FOR ANY ERRORS OR OMISSIONS WHICH MAY BE INCORPORATED HEREIN AS A RESULT.

engineering | architecture | geospatial
www.grwinc.com

ENGINEER/ARCHITECT: GRW Engineers, Inc.

HUGHES EXCAVATING,LLC

03/13/2017

This document, originally issued, sealed, and signed by Barry L. Cloyd, Tennessee Professional Engineer, No. 100893, on December 14, 2015, shall not be used in lieu of a certified document.

RECORD DRAWINGS

GRW PROJECT NO. 4420-01

ALL RIGHTS RESERVED
THIS DOCUMENT IS THE PROPERTY OF GRW ENGINEERS, INC. AND SHALL NOT BE REPRODUCED IN WHOLE, OR IN PART OR FURNISHED TO ANY PERSON OR ENTITY OTHER THAN THIS SPECIFIC PROJECT WITHOUT WRITTEN PERMISSION

engineering | architecture | geospatial
www.grwinc.com

LINE "A" - STA. 0+00 TO STA. 14+40
LINE "B" - STA.8+00 TO STA. 62+00
LOST CREEK RD. & RUSSELL CREEK RD. WATER LINES
CITY OF LOBELVILLE, TENNESSEE

DESIGNED:	DRAWN:	REVIEWED:	APPROVED:
BLC	DM/LEN	BLC	BLC

REVISIONS

NO.	DESCRIPTION	DATE	BY
1	ADDED LMI / NON-LMI RESIDENCES	2/17/16	DM
2	RESTATIONED WATER LINES	2/24/16	DM
3	HANG NEW 6" DIP WATER LINE FROM BOTTOM OF BRIDGE	4/14/16	NA
	CHANGED 8" PVC W.L. TO 6" PVC W.L.		

SCALE CHECK: THIS MARK SHOULD MEASURE EXACTLY 1" WHEN PLOTTED

DATE: OCTOBER 2015

SCALE: 1" = 100'

SHEET NO. C-06

PLOTTED BY: nazad
PRINTED: 5/11/2017 @ 12:56PM
FILE NAME: G:\4420-Lobelville\01-Russell Lost\Working Drawings\AutoCAD - Record Drawing\4420-01-C-02_C-08.dwg