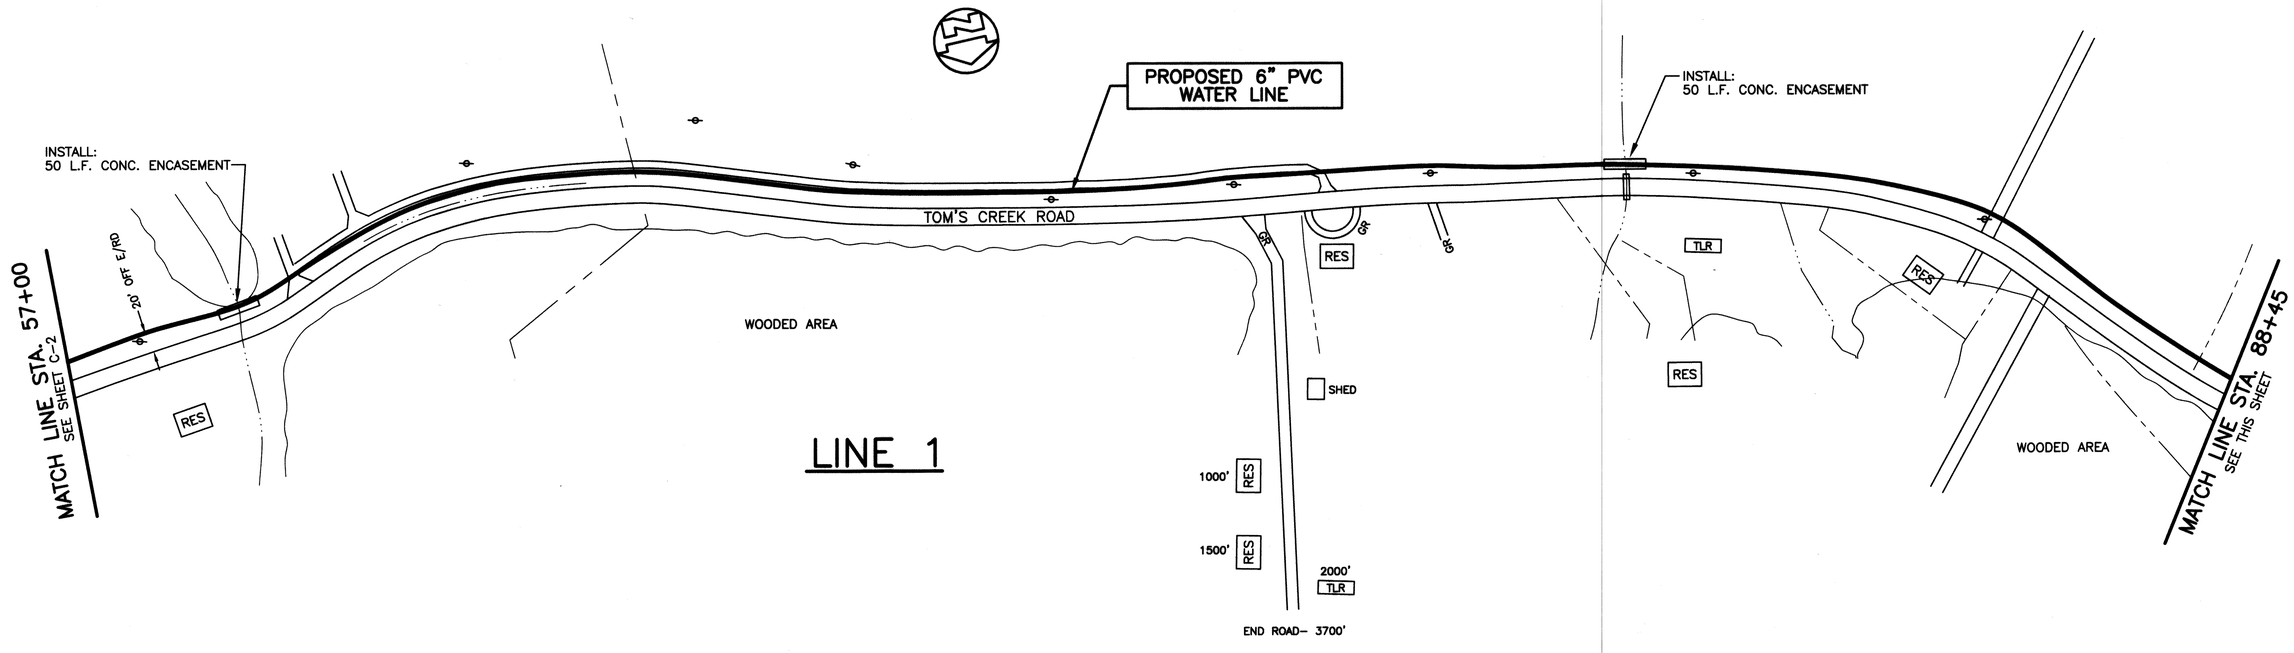

LINE 1

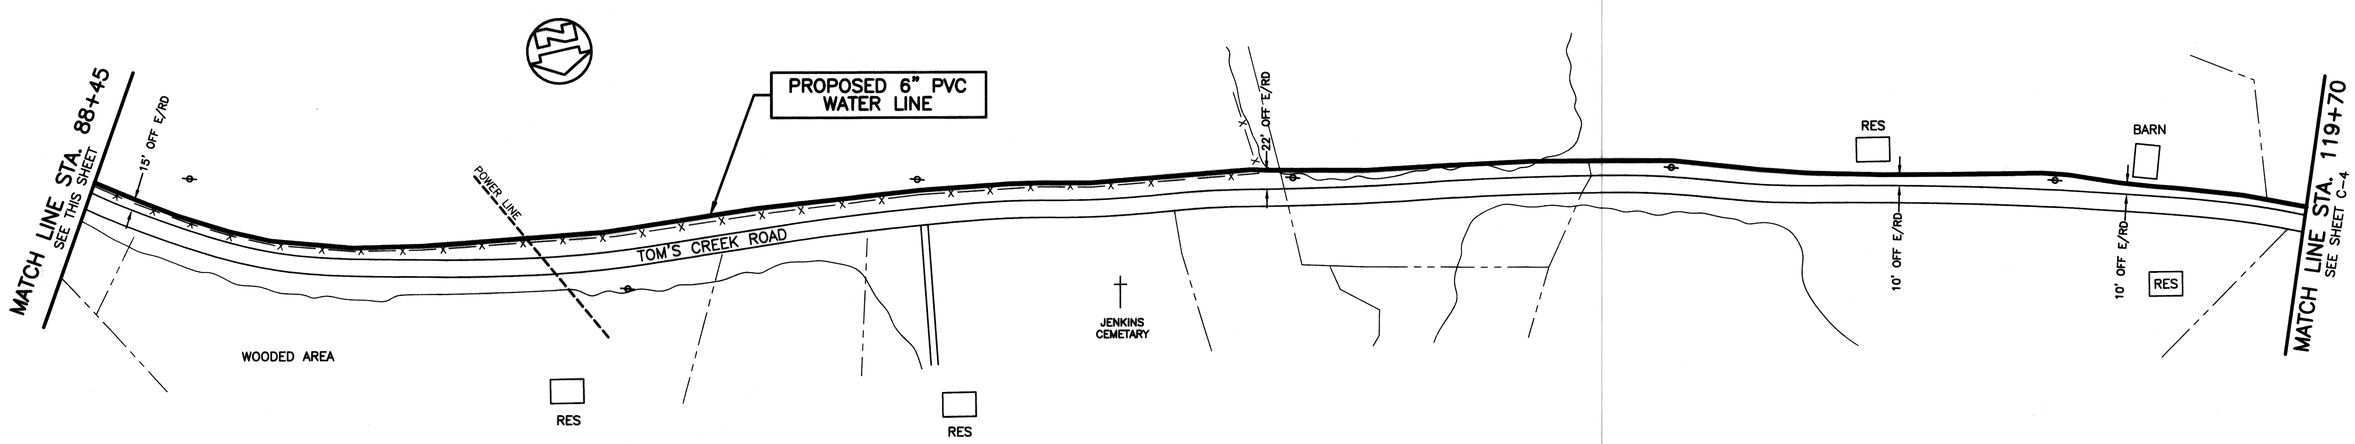

LINE 1

BURIED TELEPHONE CABLE
TEL. 1-800-351-1111 , TN ONE CALL

FILE NAME:7385C-3.DWG

GRW PROJECT NO. 7385-03

ALL RIGHTS RESERVED:
THIS DOCUMENT IS THE PROPERTY OF GRW ENGINEERS, INC. AND SHALL NOT BE REPRODUCED IN WHOLE OR IN PART OR USED FOR CONSTRUCTION OF OTHER THAN THIS SPECIFIC PROJECT WITHOUT WRITTEN PERMISSION OF GRW ENGINEERS, INC.

NO.	DESCRIPTION	DATE	BY

REVISIONS

JAMES W. HILDEBRAND III
REGISTERED AGRICULTURAL ENGINEER
STATE OF TENNESSEE
11-13-98

TOM'S CREEK ROAD – 6" WATER LINE
LOBELVILLE, TENNESSEE

GRW Engineers, Inc.
Engineers, Architects, Planners
LEXINGTON LOUISVILLE NASHVILLE INDIANAPOLIS

DESIGNED: KRS	DATE: OCTOBER, 1998
DRAWN: GAM	SCALE: 1"= 100'
REVIEWED: KRS	SHEET NO. C-3
APPROVED: JWH	