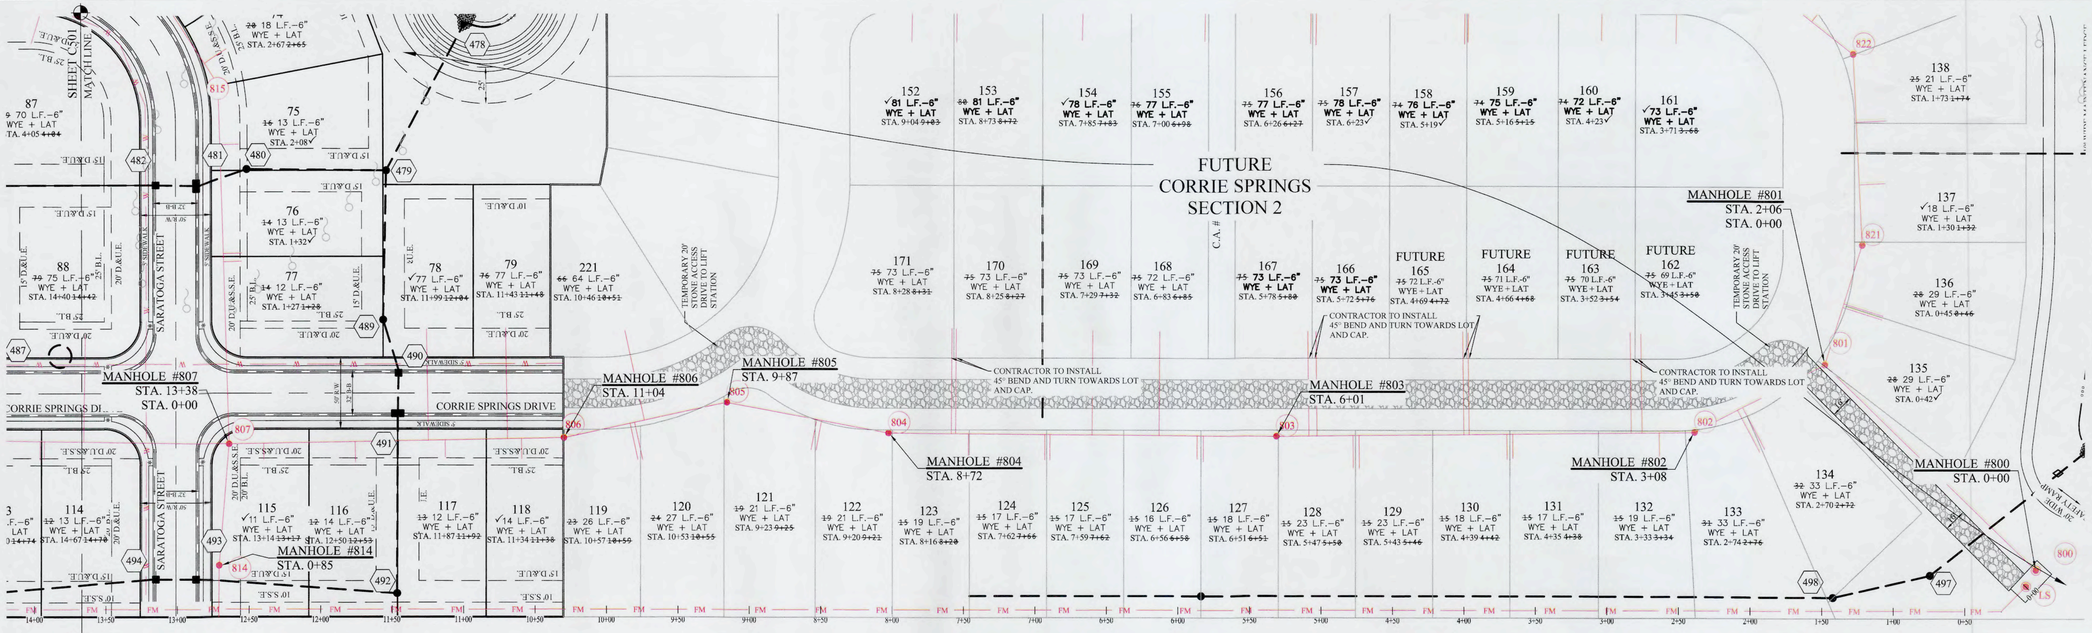

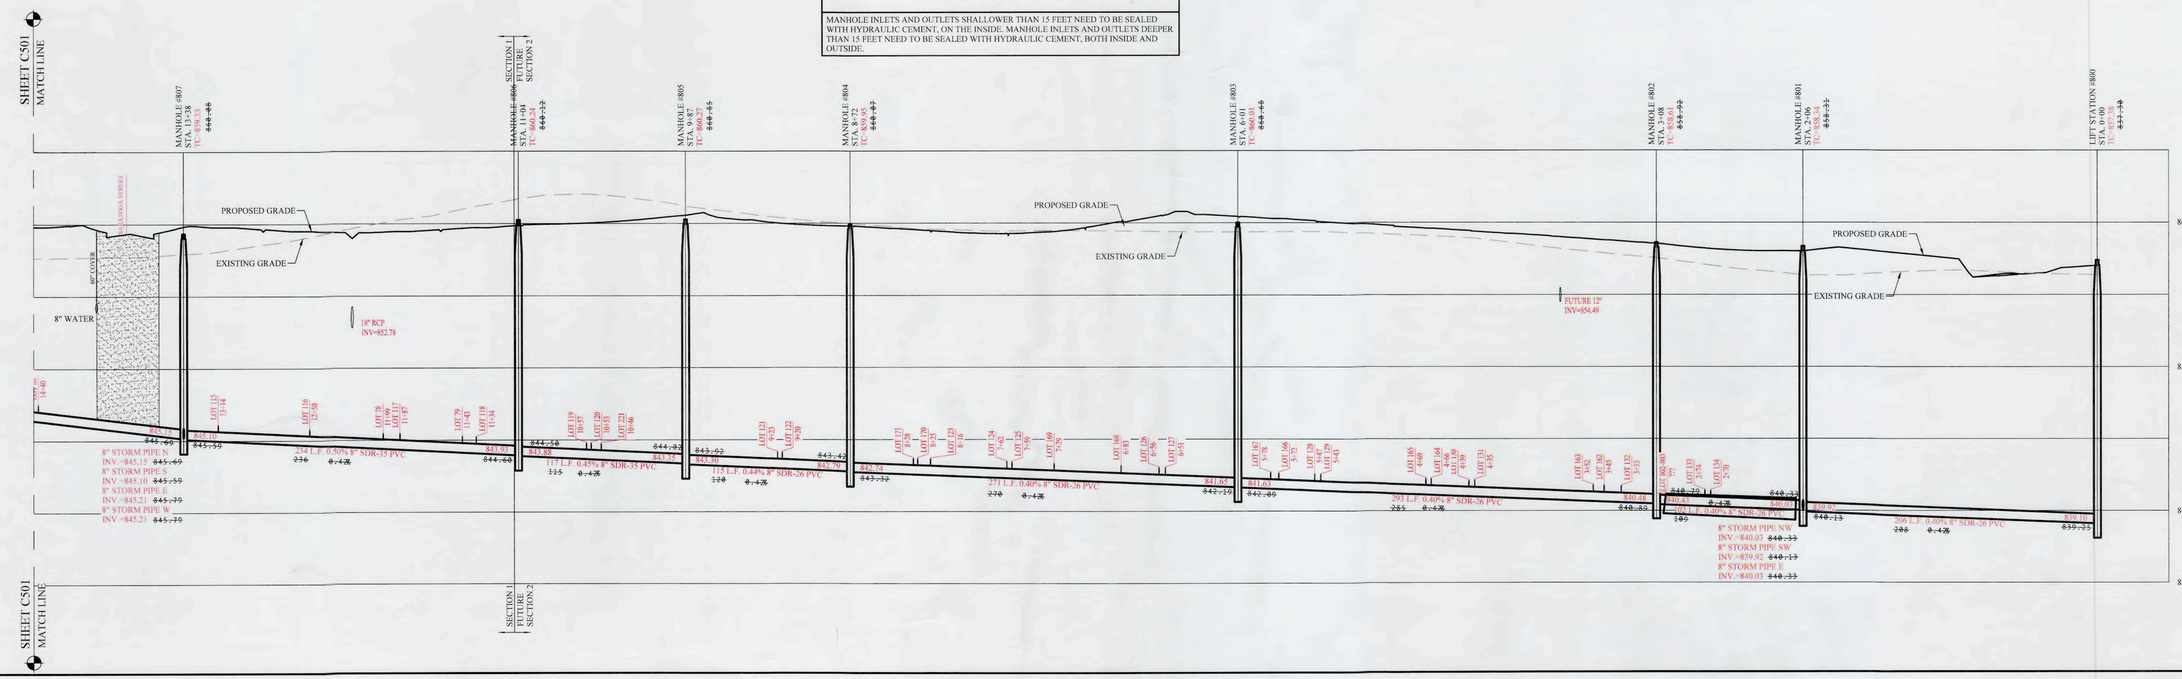

LEGEND

- EXISTING SANITARY SEWER
- EXISTING STORM SEWER
- W — EXISTING WATER LINE
- PROPOSED SANITARY SEWER (w/ LATERALS)
- PROPOSED STORM SEWER
- W — PROPOSED WATER LINE
- DENOTES FULL DEPTH GRANULAR BACKFILL

UTILITY CROSSINGS

CONTRACTOR SHALL VERIFY DEPTHS OF ALL EXISTING ONSITE UTILITIES PRIOR TO CONSTRUCTION TO CONFIRM THERE IS NOT ANY CONFLICTS WITH OTHER UTILITIES, STORM SEWERS OR STREETS. CONFLICTS AFTER CONSTRUCTION BEGINS ARE SOLELY THE CONTRACTOR'S RESPONSIBILITY.

NOTES

- ALL LATERALS TO BE INSTALLED WITH #12 GREEN TONE WIRE, STARTING FROM THE MAIN.
- ALL LATERALS MUST BE MARKED WITH A 4"x4" POST.
- MANHOLE INLETS AND OUTLETS SHALLOWER THAN 15 FEET NEED TO BE SEALED WITH HYDRAULIC CEMENT, ON THE INSIDE. MANHOLE INLETS AND OUTLETS DEEPER THAN 15 FEET NEED TO BE SEALED WITH HYDRAULIC CEMENT, BOTH INSIDE AND OUTSIDE.

RECORD DRAWING

GRAPHIC SCALE
50' 0 25' 50'
(IN FEET)
1" = 50 FT

Dennis D. Olmstead
Professional Land Surveyor
No. 900012
9/23/2025

DENNIS D. OLMSTEAD REGISTERED No. 900012 STATE OF INDIANA LAND SURVEYOR

THIS DRAWING IS NOT INTENDED TO BE REPRESENTED AS A RETRACEMENT OR ORIGINAL BOUNDARY SURVEY, A ROUTE SURVEY OR A SURVEY/OR LOCATION REPORT.

CERTIFIED: 04/04/25

BRIAN MILLER BROWN REGISTERED No. PE11200386 STATE OF INDIANA PROFESSIONAL ENGINEER

MARK	DATE	REVISIONS	BY
1	04/30/25	REVISED PER REVIEW COMMENTS	GEM
2	05/09/25	REVISED PPH. MATERIAL	CDW
3	06/04/25	REVISED PER ICRW COMMENTS	KRG
4	09/28/25	AS BUILTS - SANITARY MAIN & LATERALS	PAH

STOEPPELWERTH
ALWAYS ON
7965 East 106th Street, Fishers, IN 46038-2505
phone: 317.849.5935 fax: 317.849.5942

SANITARY SEWER PLAN & PROFILES
CORRIE SPRINGS
SECTION 1
INGALLS — MADISON COUNTY, INDIANA

DRAWN BY: RPL | CHECKED BY: KRG

SHEET NO.
C500

S & A JOB NO.
104869FOR-S1

File Name: S:\104869FOR-S1\DWG\C500 - Sanitary Plan & Profile.dwg - C500
Modified / By: September 28, 2026 12:14:18 PM / mevans
Plotted / By: September 28, 2026 12:14:40 PM / Michael Evans