


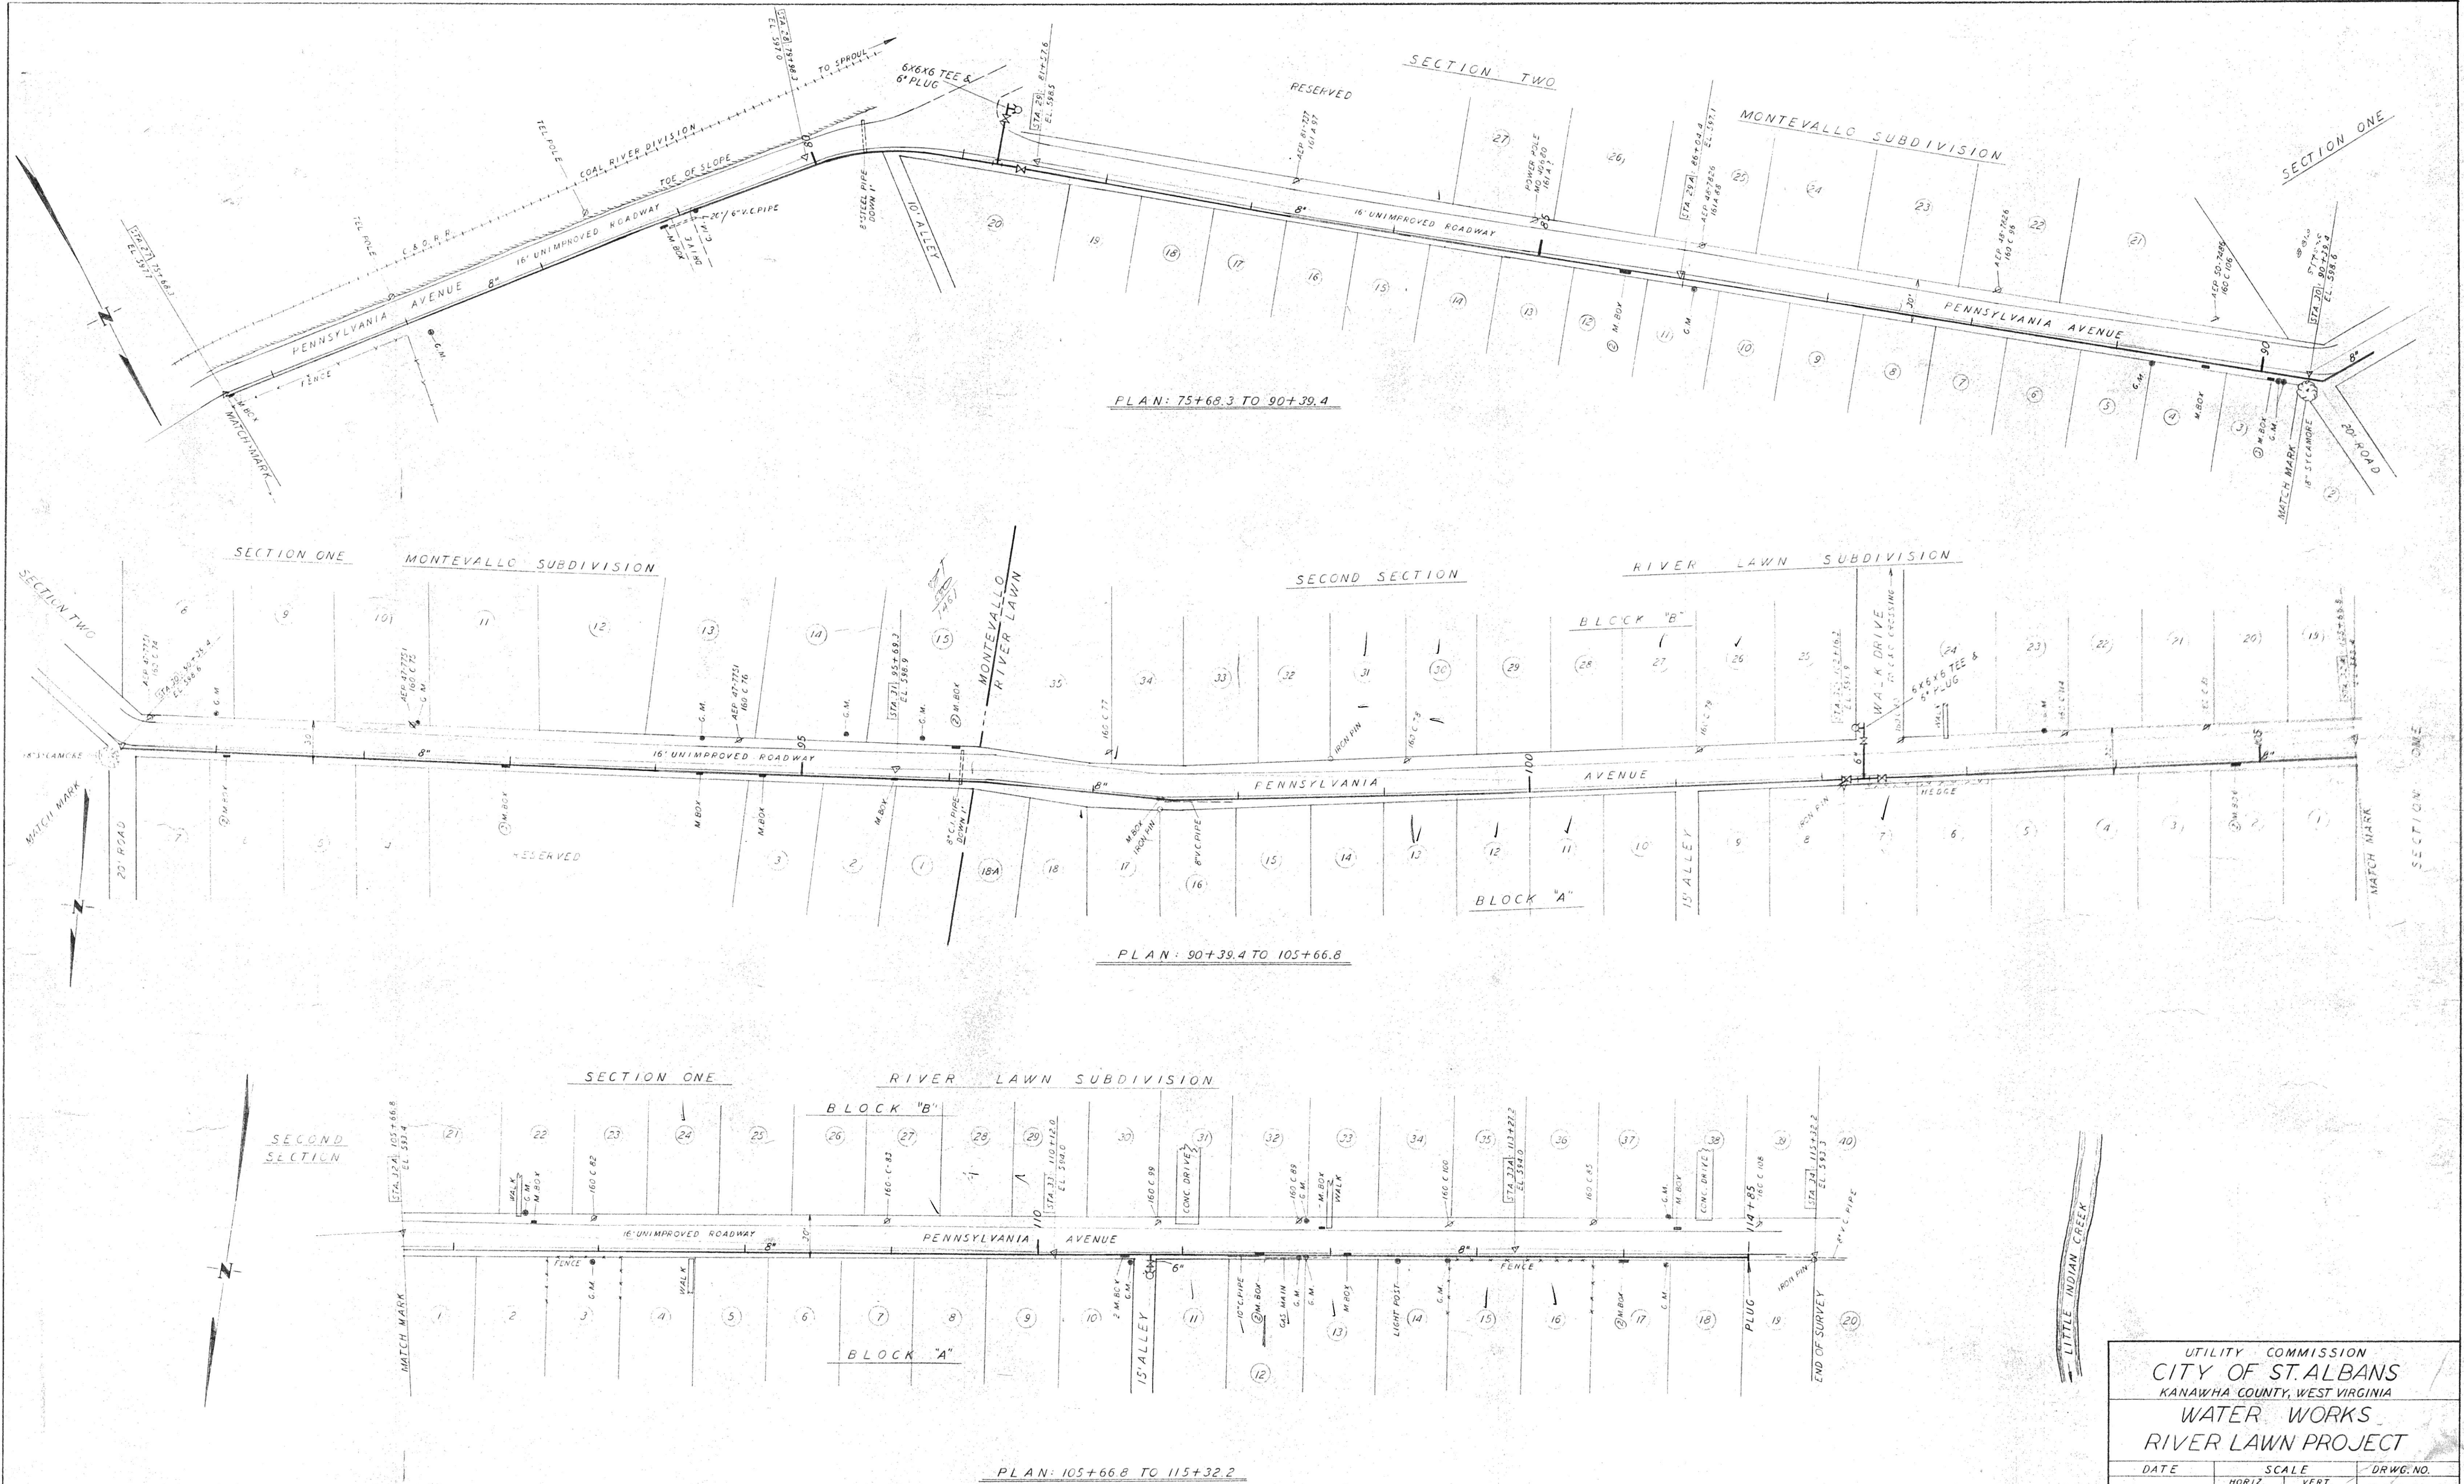

UTILITY COMMISSION CITY OF ST. ALBANS KANAWHA COUNTY, WEST VIRGINIA WATER WORKS RIVER LAWN PROJECT		
DATE	SCALE	DRWG. NO.
NOV. 11-1953	HORIZ. 1" = 50' VERT. 1" = 10'	2003-0
W. D. KELLEY, CONSULTING ENGINEER CHARLESTON, WEST VIRGINIA		