


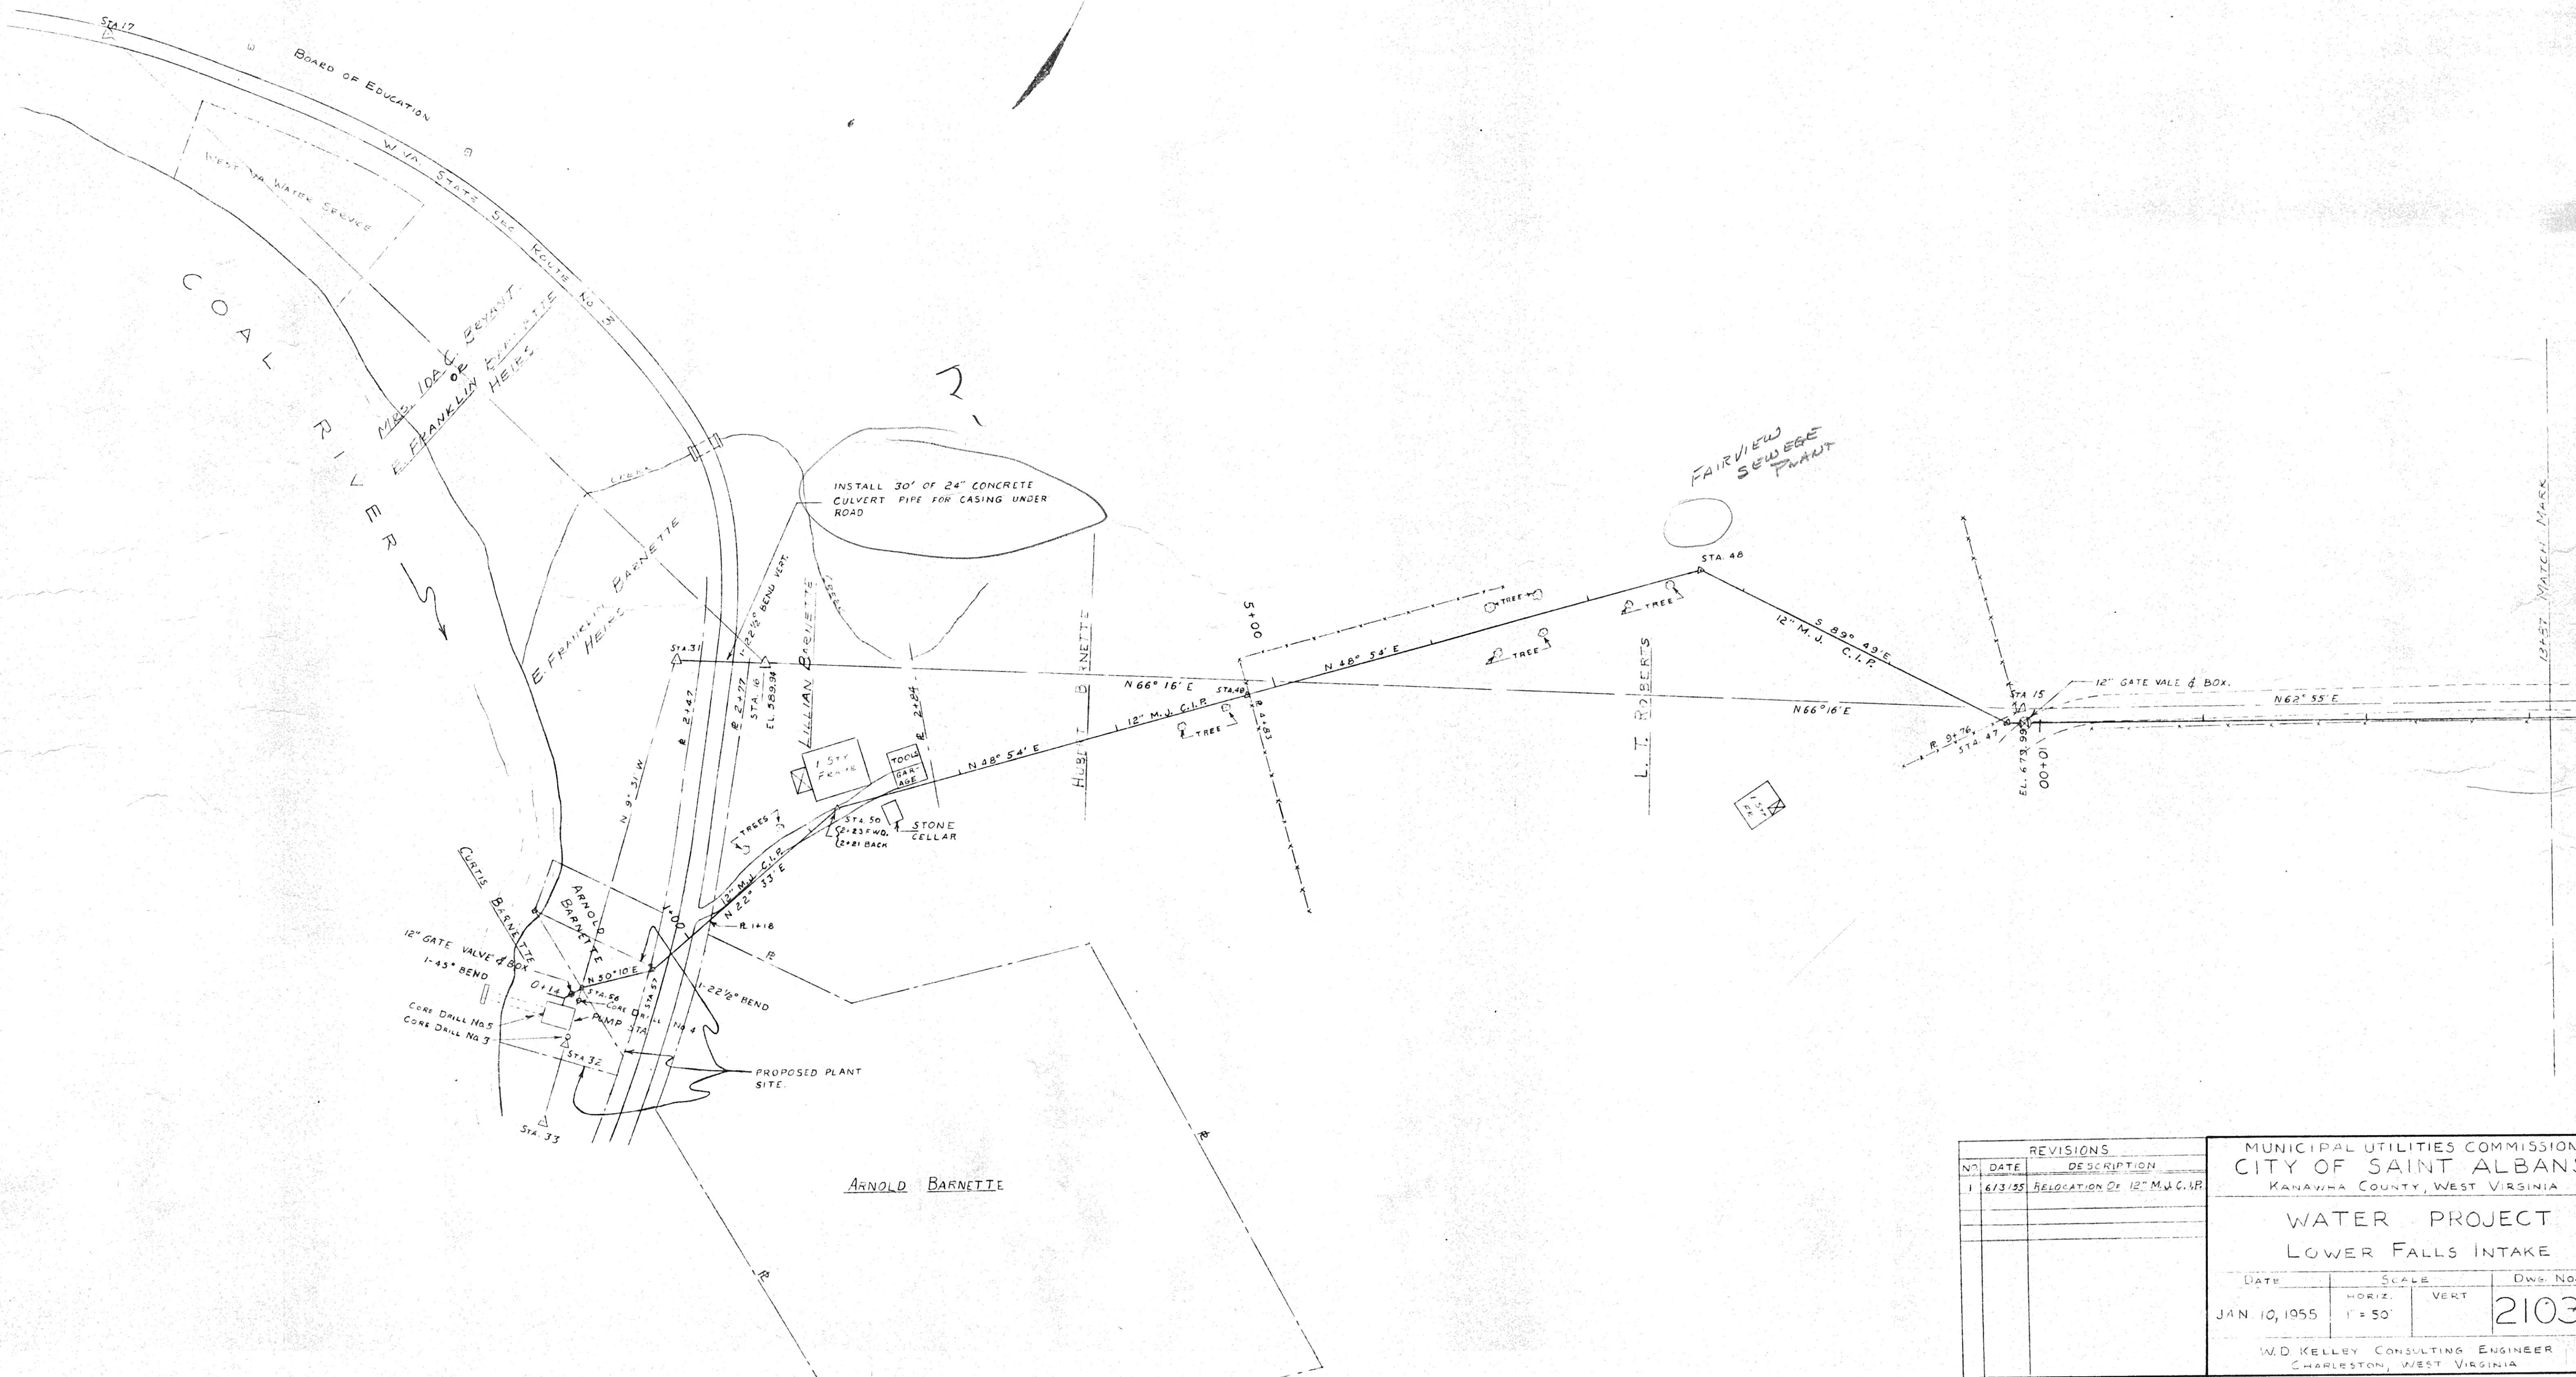

REVISIONS	
NO.	DATE
1	6/13/55
	RELOCATION OF 12" M.S.L.R.

MUNICIPAL UTILITIES COMMISSION CITY OF SAINT ALBANS KANAWHA COUNTY, WEST VIRGINIA		
WATER PROJECT LOWER FALLS INTAKE		
DATE JAN 10, 1955	SCALE HORIZ. 1" = 50'	DWG. NO. 2103-1
W.D. KELLEY CONSULTING ENGINEER CHARLESTON, WEST VIRGINIA		