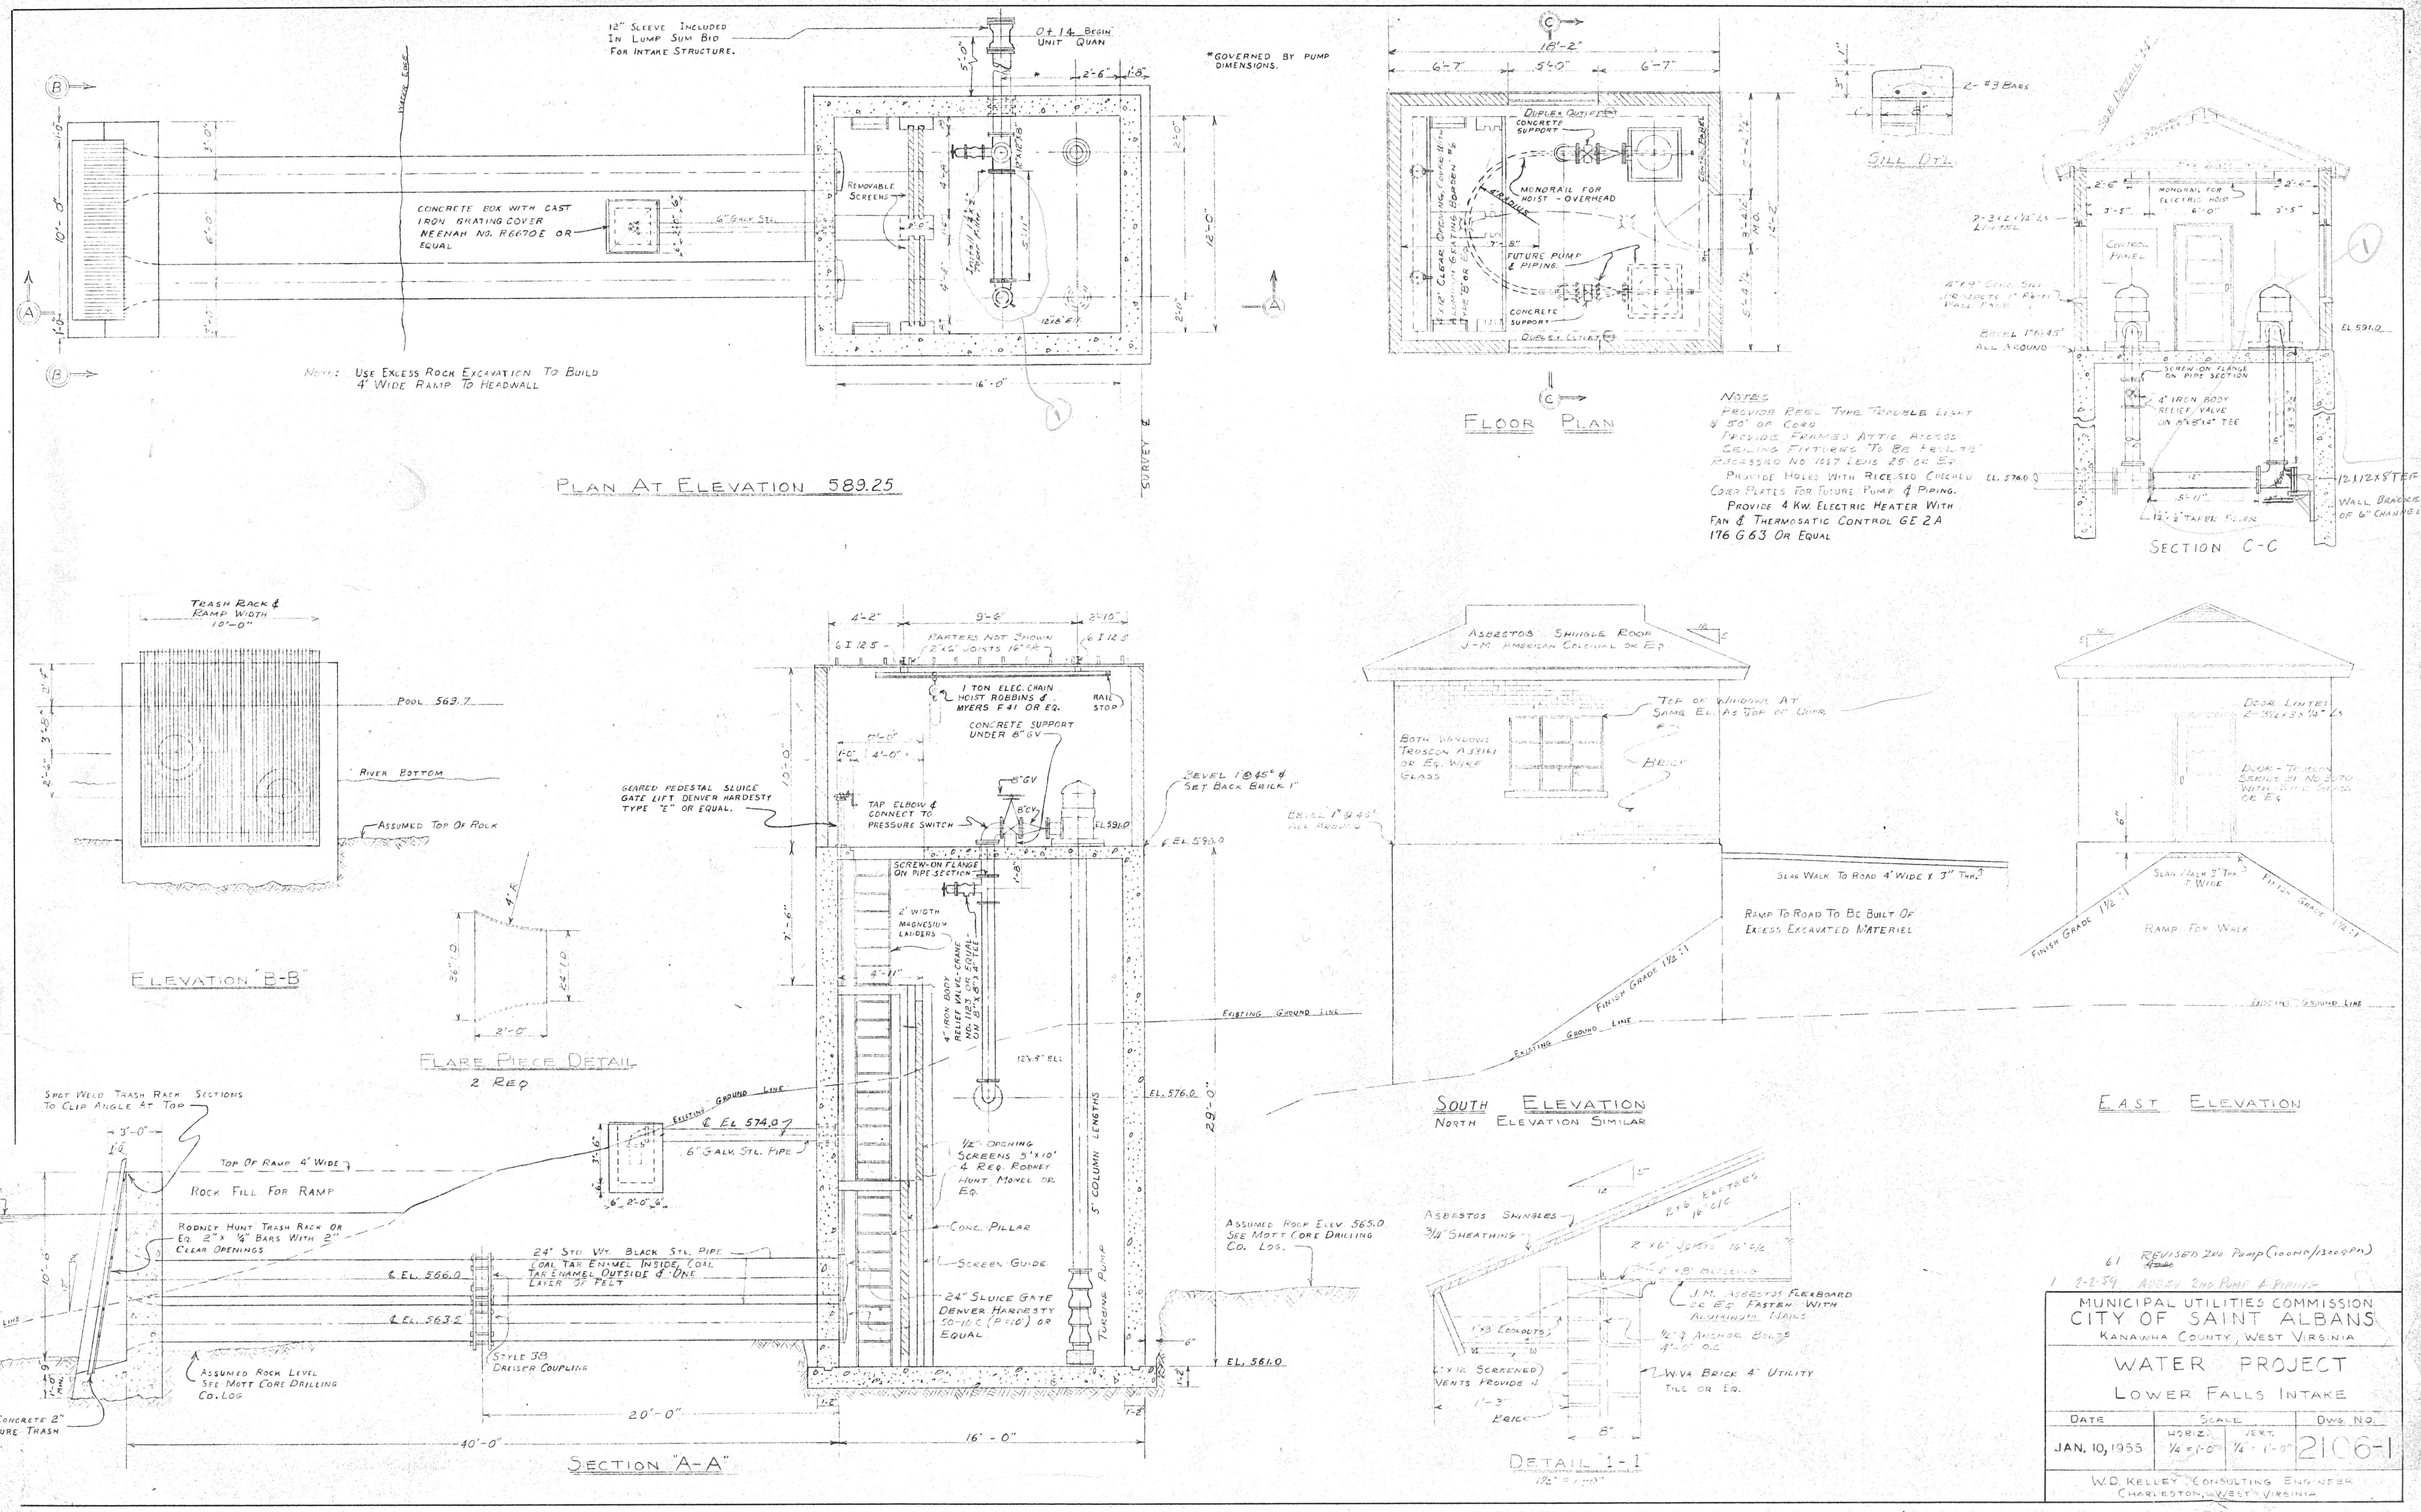

61 REVISED 200 Pump (1000M/1300GPM)
1 9-2-59 ADDED 2ND PUMP & PIPING

MUNICIPAL UTILITIES COMMISSION
CITY OF SAINT ALBANS
KANAWHA COUNTY, WEST VIRGINIA

WATER PROJECT
LOWER FALLS INTAKE

DATE	SCALE		DWG. NO.
	HORIZ.	VERT.	
JAN. 10, 1955	1/4" = 1'-0"	1/4" = 1'-0"	2106-1

W.D. KELLEY CONSULTING ENGINEER
CHARLESTON, WEST VIRGINIA