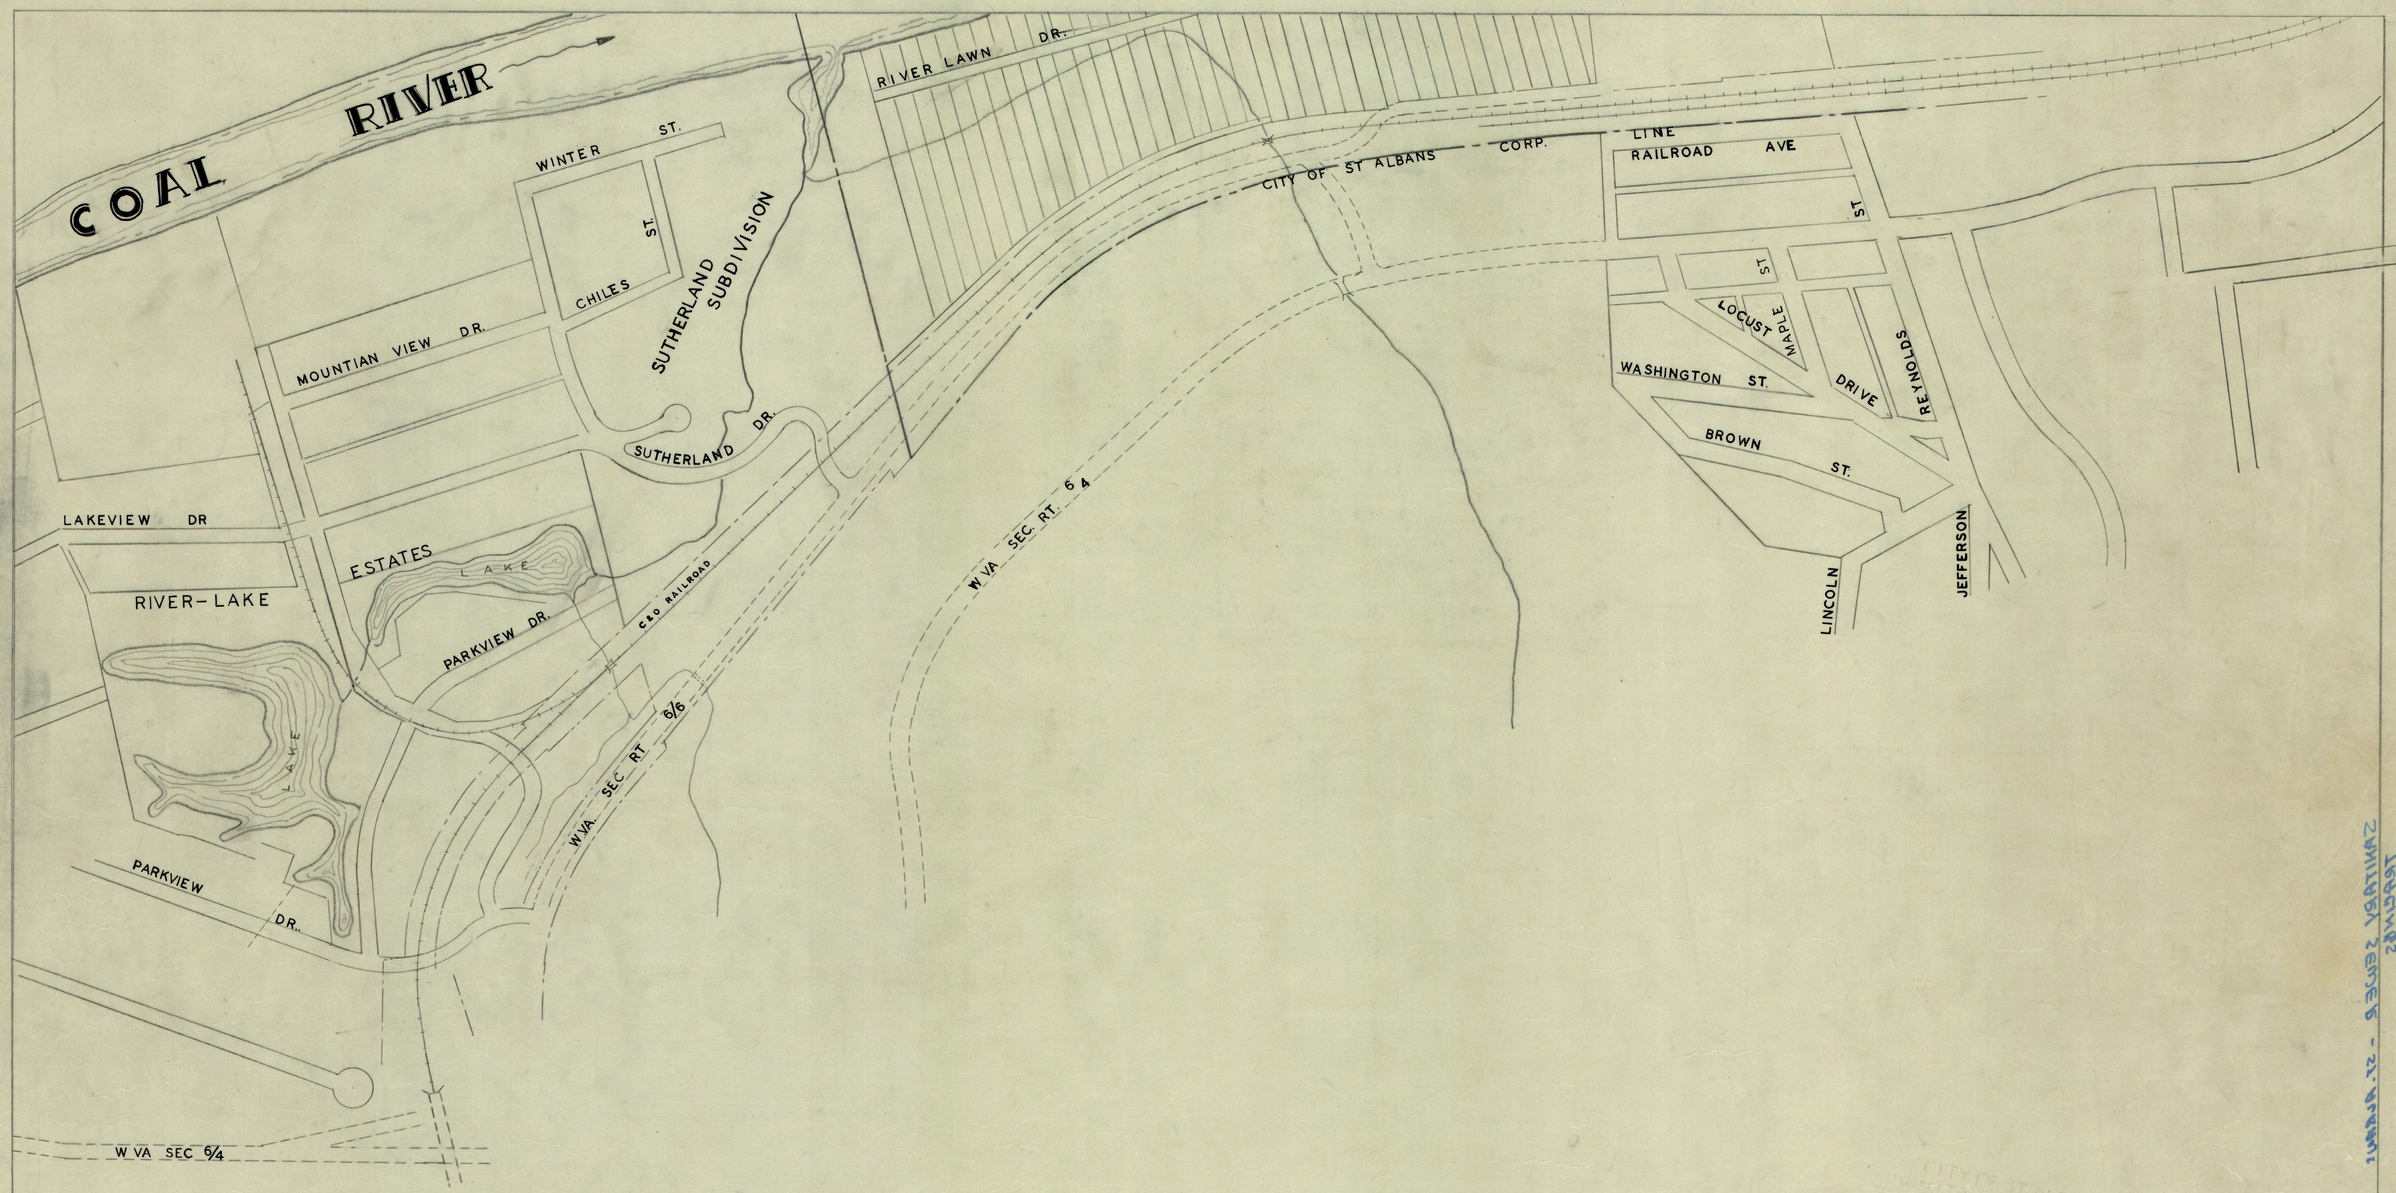

MUNICIPAL ENGINEERING CORP.

CITY OF ST. ALBANS SANITARY SEWER SYSTEM			
SCALE: 1"=200'	DRAWN: JBG	3-60	SHEET No. 7
	CHECK:		
	REVISED: JBG	1-61	