PLAN — SURVEYED / PLOTTED / NOTE BOOK / No. — ALIGNMENT CHECKED / R.W. OR EASEMENTS CHECKED / STRUCTURE NOTATIONS CHECKED — BY / DATE

PROFILE — SURVEYED / PLOTTED / NOTE BOOK / No. — GRADES CHECKED / R.W. OR EASEMENTS CHECKED / STRUCTURE NOTATIONS CHECKED — BY / DATE

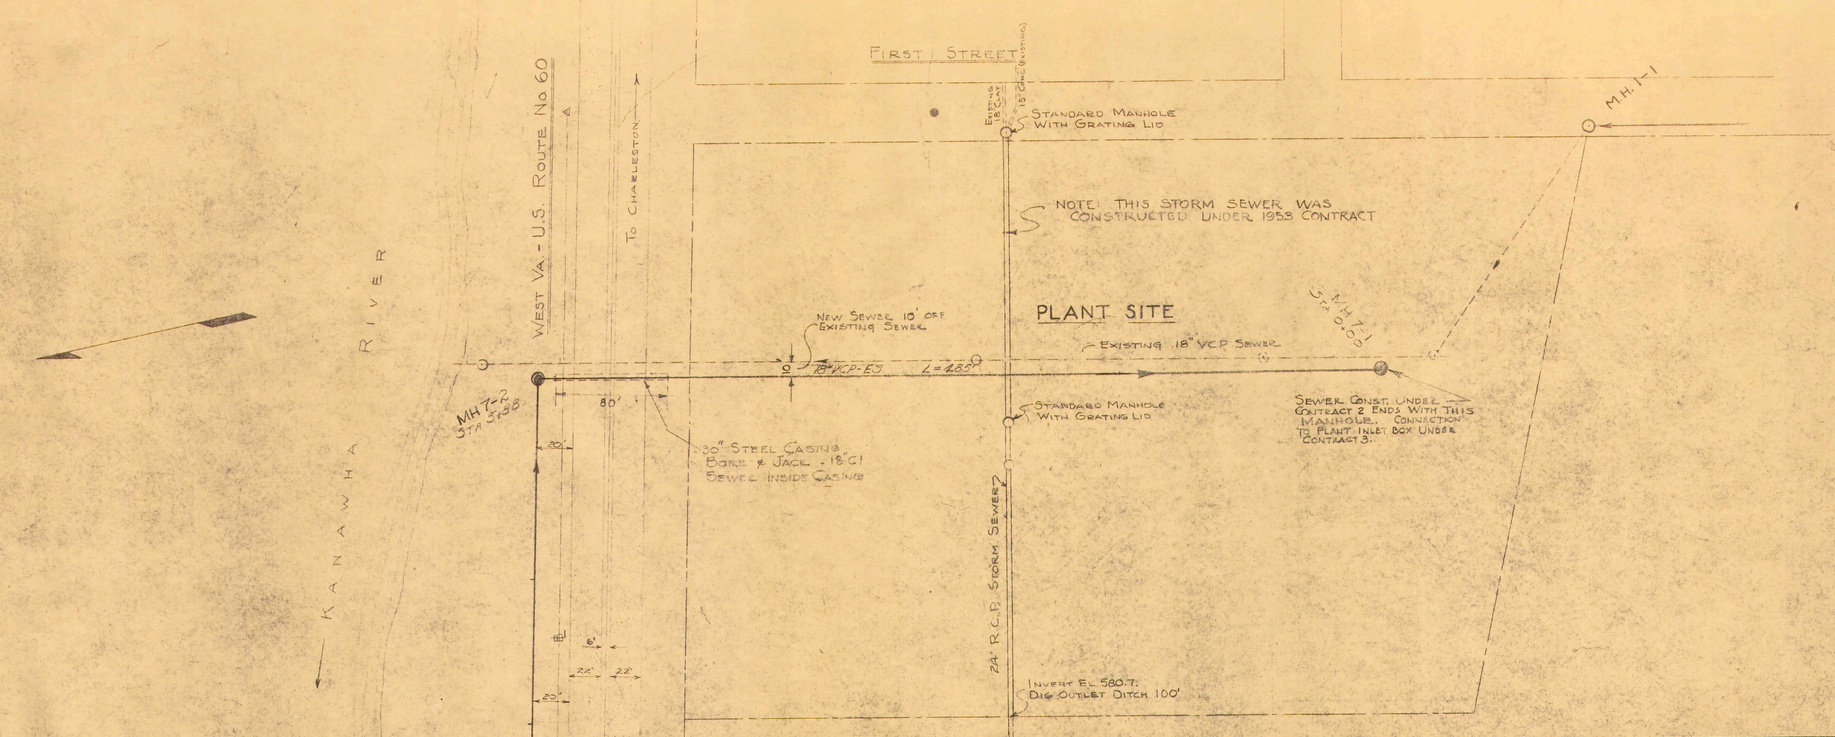

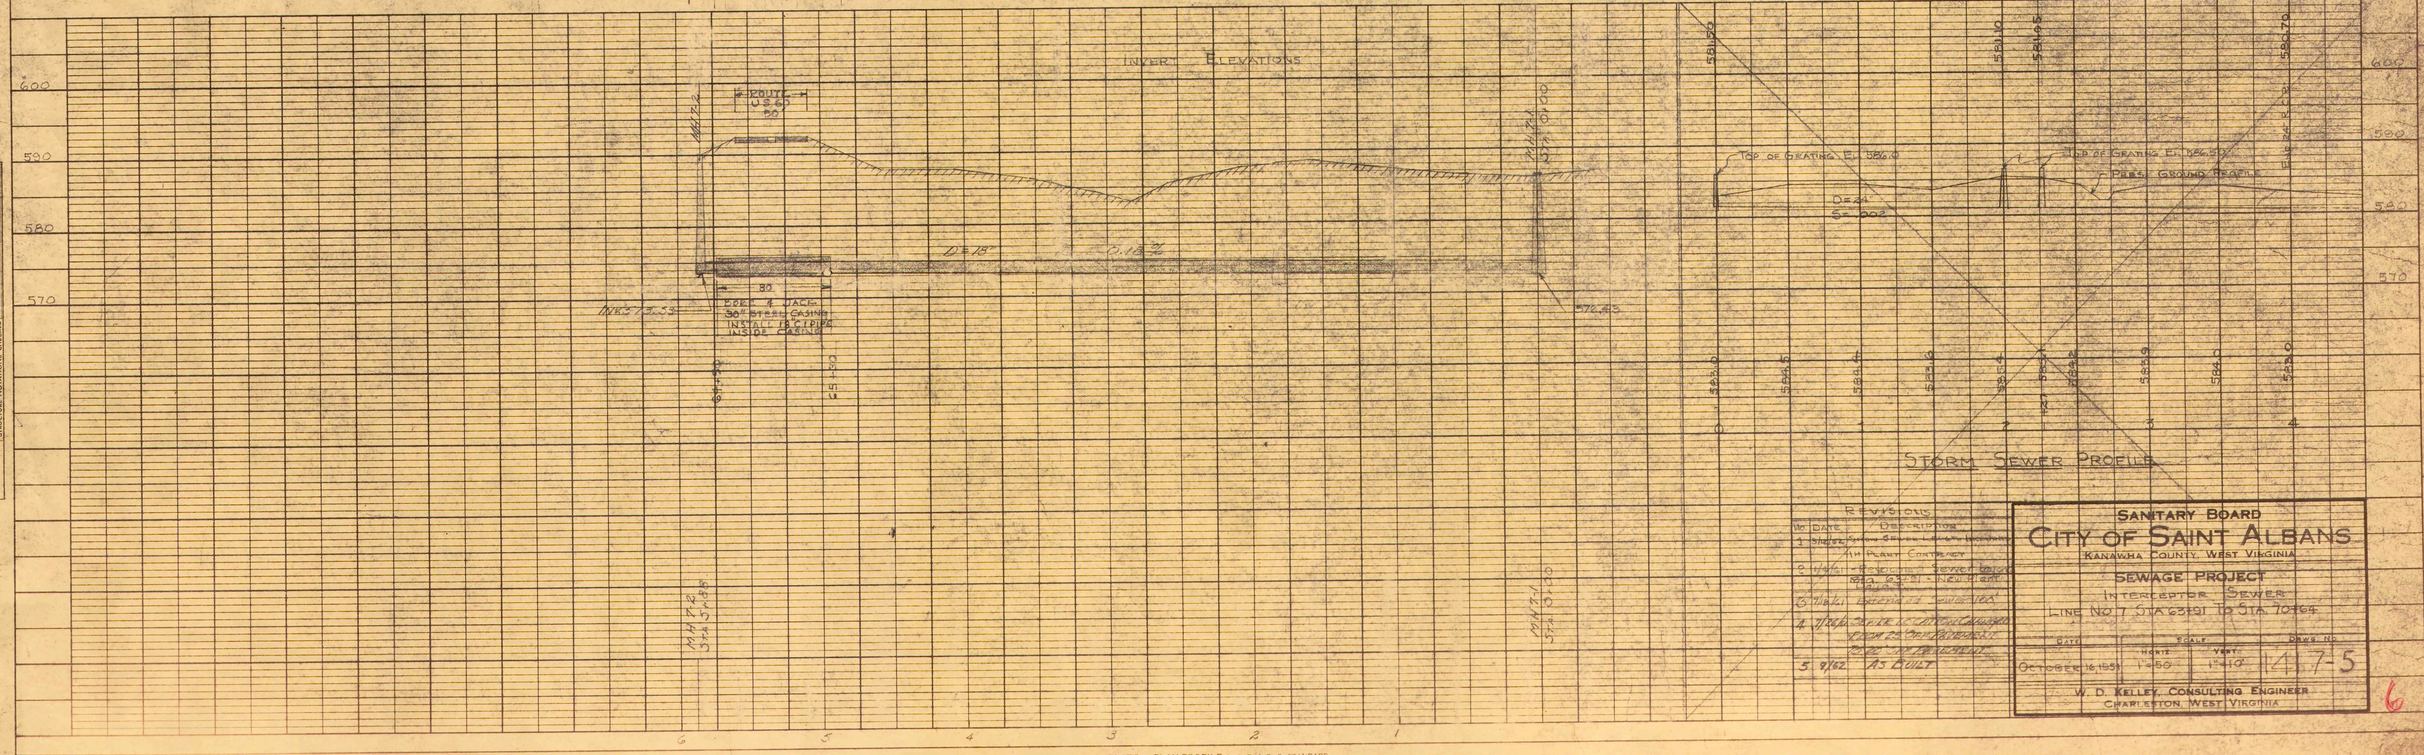

REVISIONS		
No.	DATE	DESCRIPTION
1	5/16/62	Storm Sewer Layout Revised to Plant Contract
2	6/14/62	Storm Sewer Revised Sta. 63+81 - New Alignment
3	6/26/62	Detail of Sewer Revised
4	7/26/62	Storm Sewer Alignment Revised from Sta 70+03 to Sta 70+64
5	9/62	As Built

SANITARY BOARD
CITY OF SAINT ALBANS
KANAWHA COUNTY, WEST VIRGINIA
SEWAGE PROJECT
INTERCEPTOR SEWER
LINE No 7 STA 63+91 TO STA 70+64

DATE	SCALE HORIZ.	SCALE VERT.	DRWG. NO.
OCTOBER 16 1961	1"=50'	1"=10'	14 7-5

W. D. KELLEY, CONSULTING ENGINEER
CHARLESTON, WEST VIRGINIA

6

PLATE 1 - PLAN-PROFILE O. P. R. & R. C. STANDARD
THE FREDERICK POST CO., CHICAGO