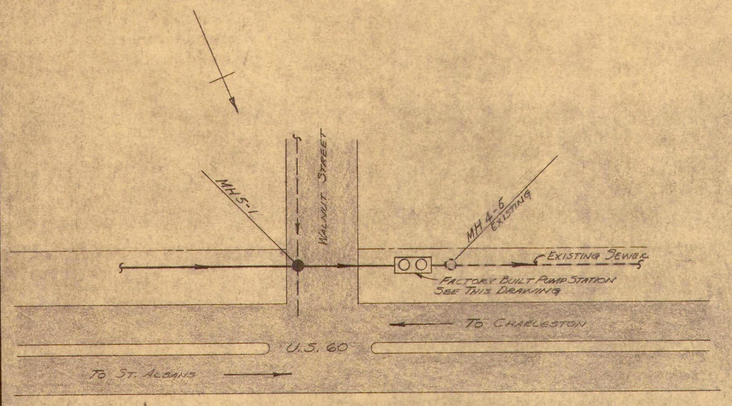

GENERAL LOCATION PLAN
(SEE DWG. 1407-2 FOR CONNECTING SEWERS)

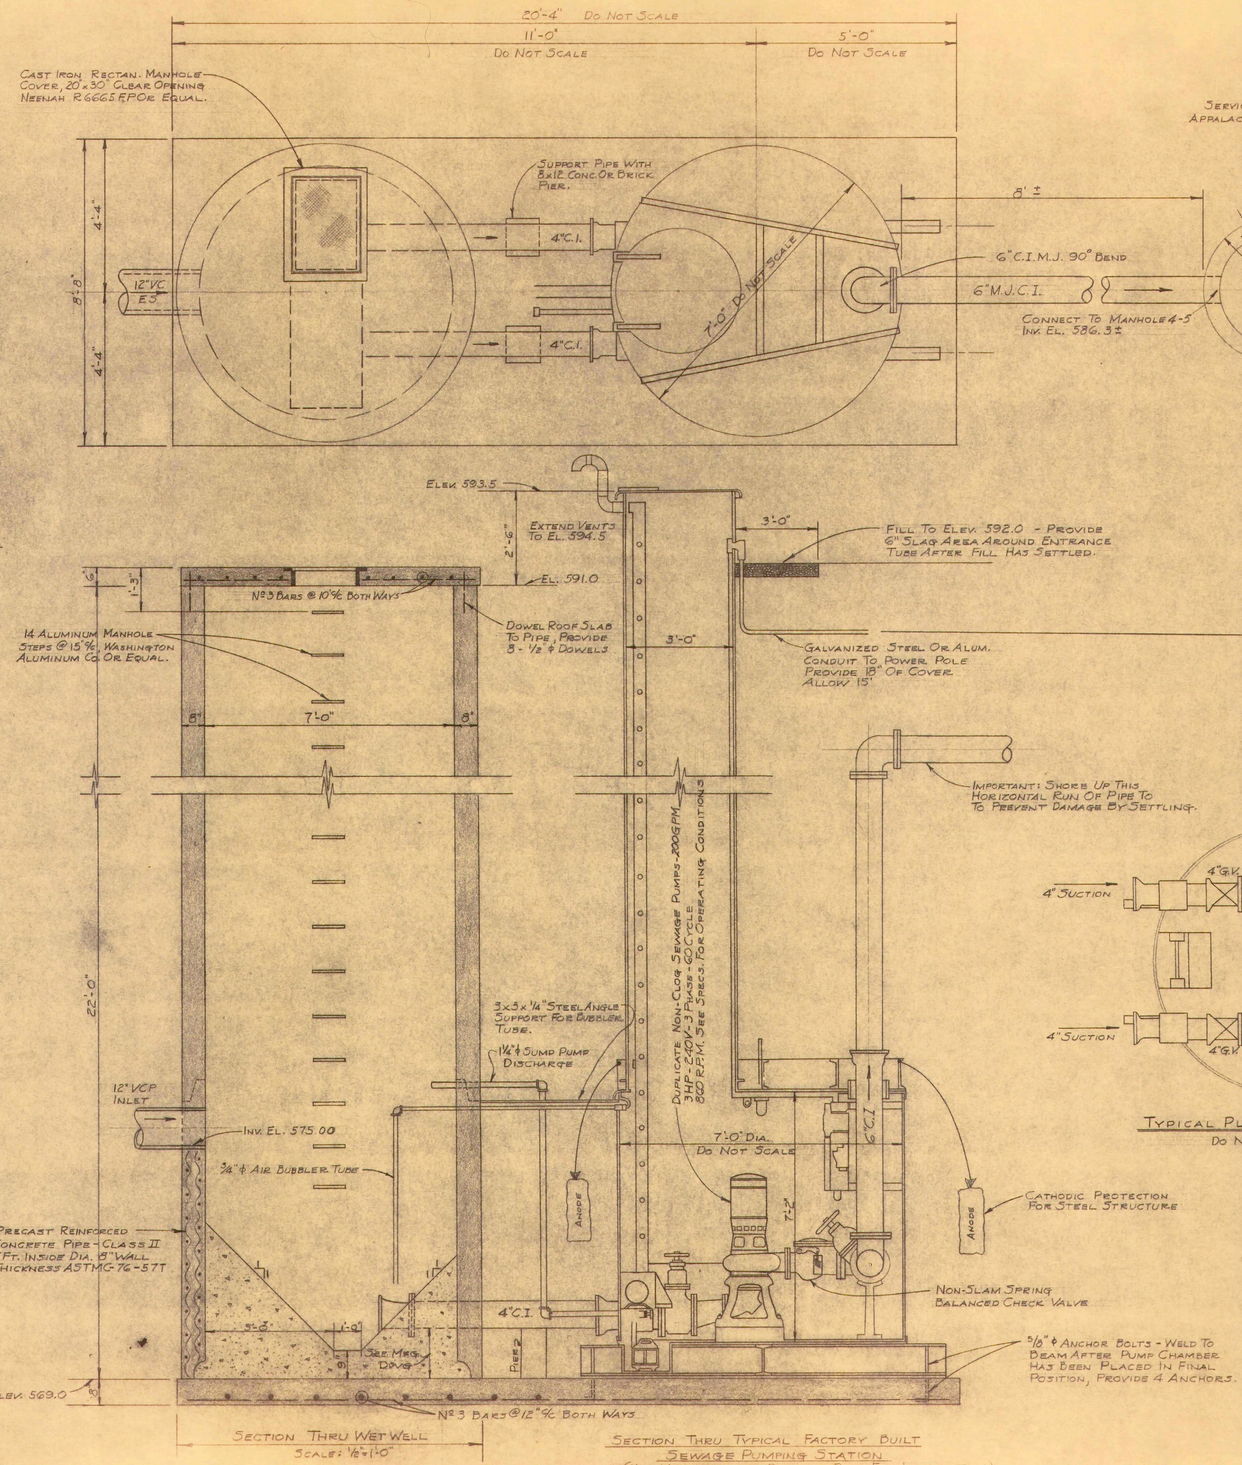

SECTION THRU WET WELL
SCALE: ½"=1'-0"

SECTION THRU TYPICAL FACTORY BUILT SEWAGE PUMPING STATION
(USE MANUFACTURER'S DRAWING ONLY FOR INSTALLATION)
DO NOT SCALE

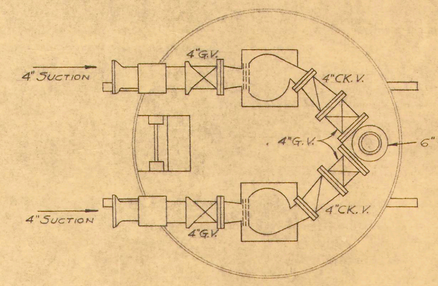

TYPICAL PLAN OF PUMP CHAMBER
DO NOT SCALE

No.	DATE	REVISIONS
1	9-62	AS BUILT

CITY OF SAINT ALBANS

KANAWHA COUNTY WEST VIRGINIA

ALTERNATE - WALNUT STREET PUMPING STATION

DATE	SCALE		DRWG. NO.
	HORIZ.	VERT.	
JAN. 1961	AS SHOWN		1428A

KELLEY, GIDLEY & STAUB INC. CONSULTING ENGINEERS
CHARLESTON, WEST VIRGINIA

18