


PROFILE		SURVEYED	BY	DATE
NOTE BOOK		PLOTTED		
B. M.'S. NOTED		GRADES CHECKED		

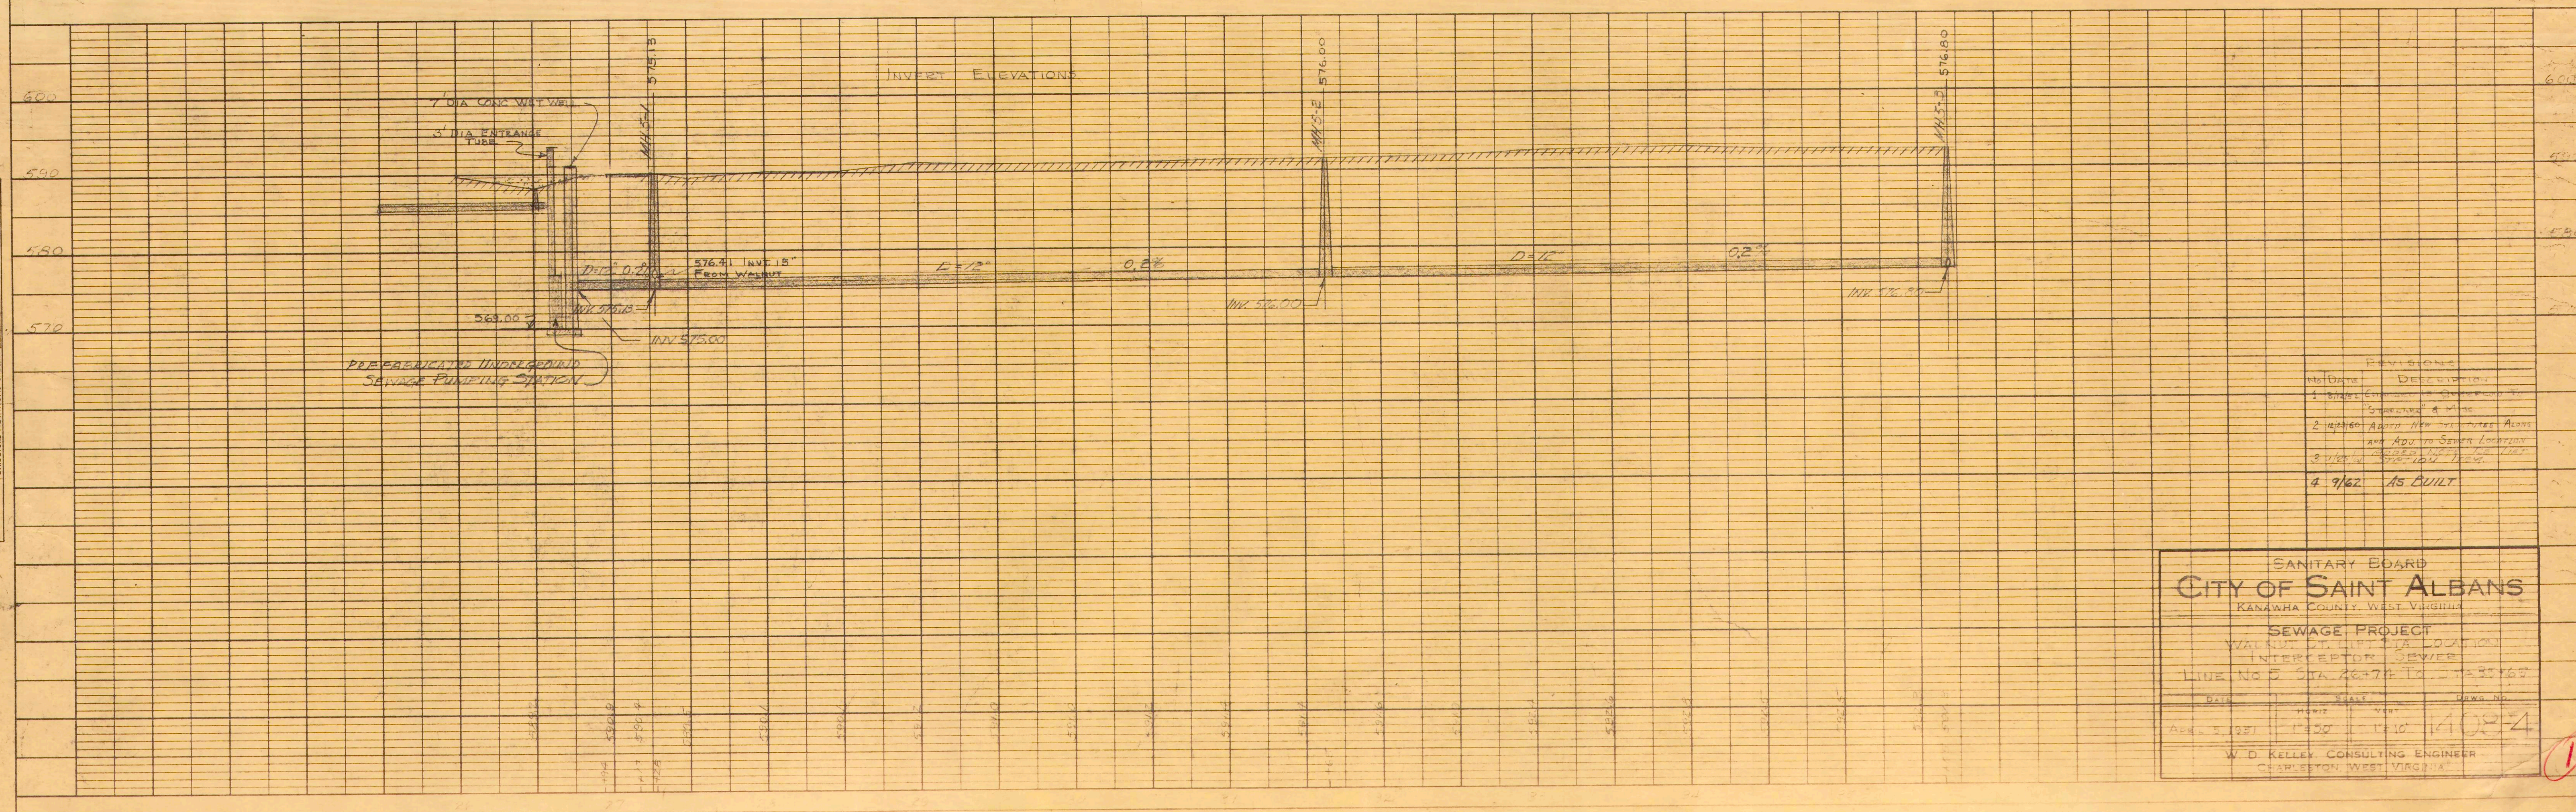

REVISIONS	
NO	DATE DESCRIPTION
4	9/6/62 AS BUILT

SANITARY BOARD
CITY OF SAINT ALBANS
KANAWHA COUNTY, WEST VIRGINIA

SEWAGE PROJECT

DATE: _____ SCALE: _____ DRAWN BY: _____
HORIZ. VERT.
1"=50' 1"=10' 1408-Z

W. D. KELLEY CONSULTING ENGINEER
CHARLESTON, WEST VIRGINIA