


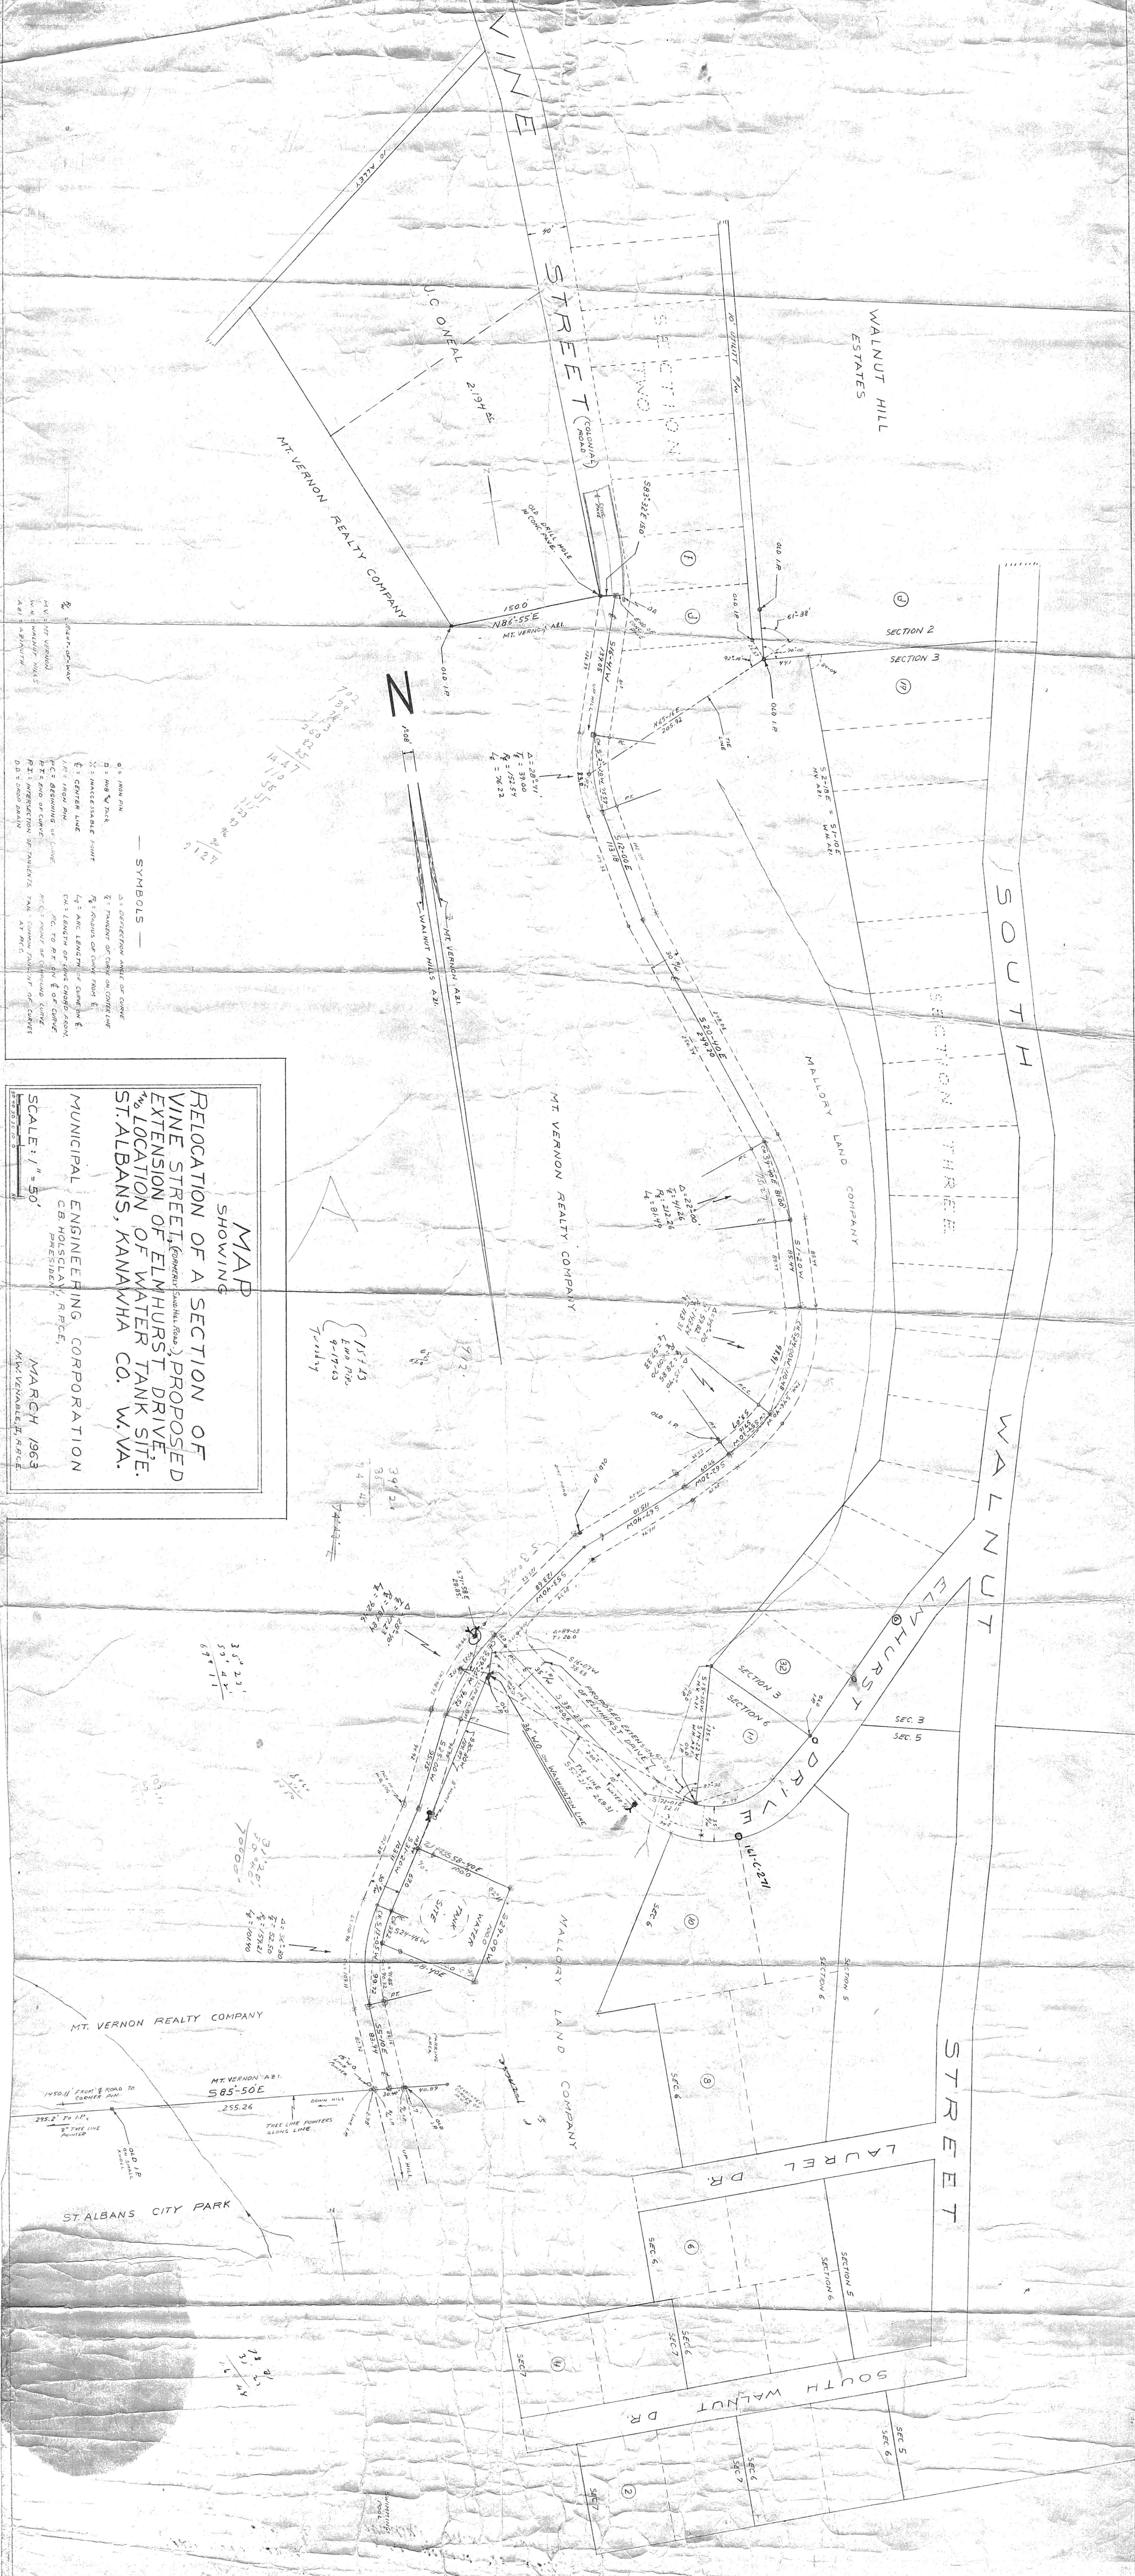

- SYMBOLS**
- Q = IRON PIN
 - D = IRON NAIL
 - X = INTERSECTION POINT
 - E = CENTER LINE
 - L = IRON PIN
 - P.T. = END OF CURVE
 - P.I. = POINT OF INTERSECTION
 - D.D. = DODD BRAIN
 - Δ = DEFLECTION ANGLE OF CURVE
 - E = POINT OF CURVE ON CENTER LINE
 - R = RADIUS OF CURVE FROM E
 - L = ARC LENGTH OF CURVE
 - CH = CHORD LENGTH OF CURVE
 - PC = POINT OF CURVE
 - PT = POINT OF CURVE
 - P.I. = POINT OF INTERSECTION
 - AT P.I.

MAP
SHOWING
RELOCATION OF A SECTION OF
VINE STREET, (FORMERLY SOUTH HILL ROAD), PROPOSED
EXTENSION OF ELMHURST DRIVE,
THE LOCATION OF WATER TANK SITE,
ST. ALBANS, KANAWHA CO. W. VA.

MUNICIPAL ENGINEERING CORPORATION
C.B. HOLMES, JR., P.E.
PRESIDENT

MARCH 1963
H.W. VENABLE, JR., P.E.

SCALE: 1" = 50'