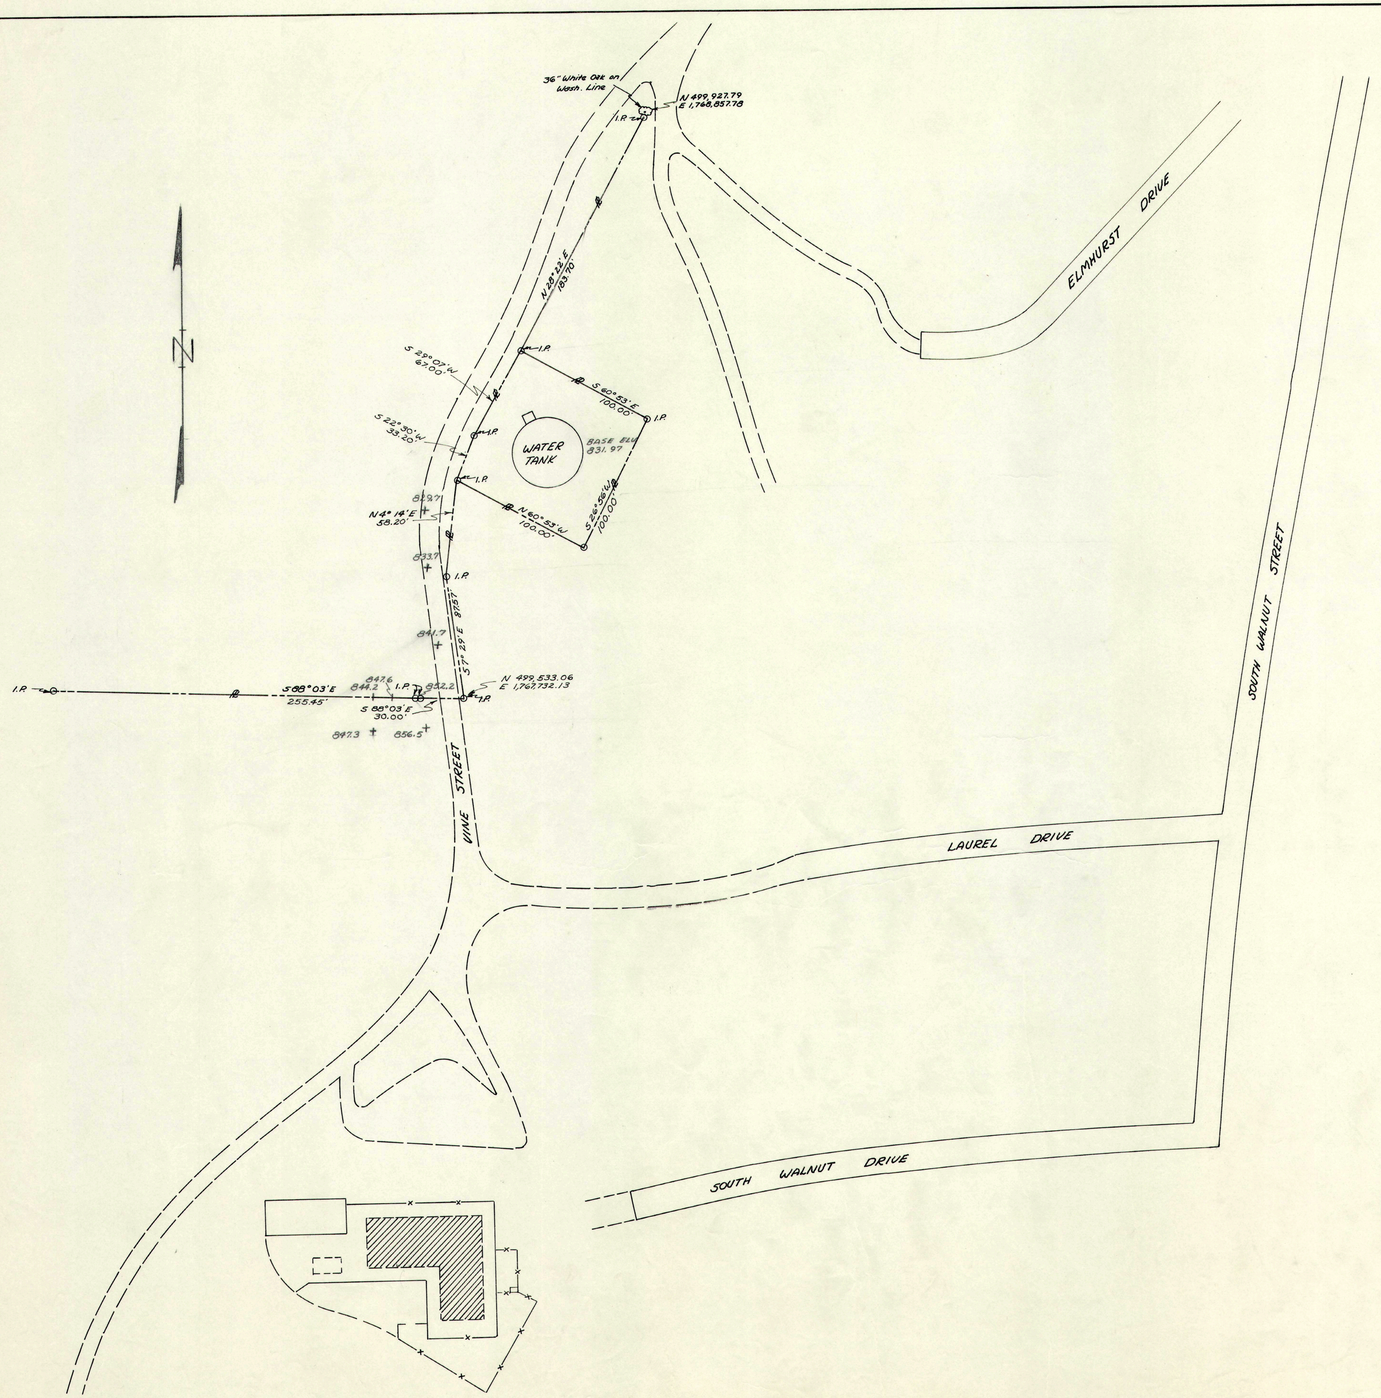

REVISED	MUNICIPAL UTILITY COMMISSION CITY OF SAINT ALBANS KANAWHA COUNTY - WEST VIRGINIA	
DATE	VINE ST. WATER TANK SITE	
	DATE: 2-23-66 / SCALE: 1" = 50' / DRAWING NO. 41	
	MAP PLAT NO.	
	DRAWN BY: DRB / CHECKED / APPROVED	