


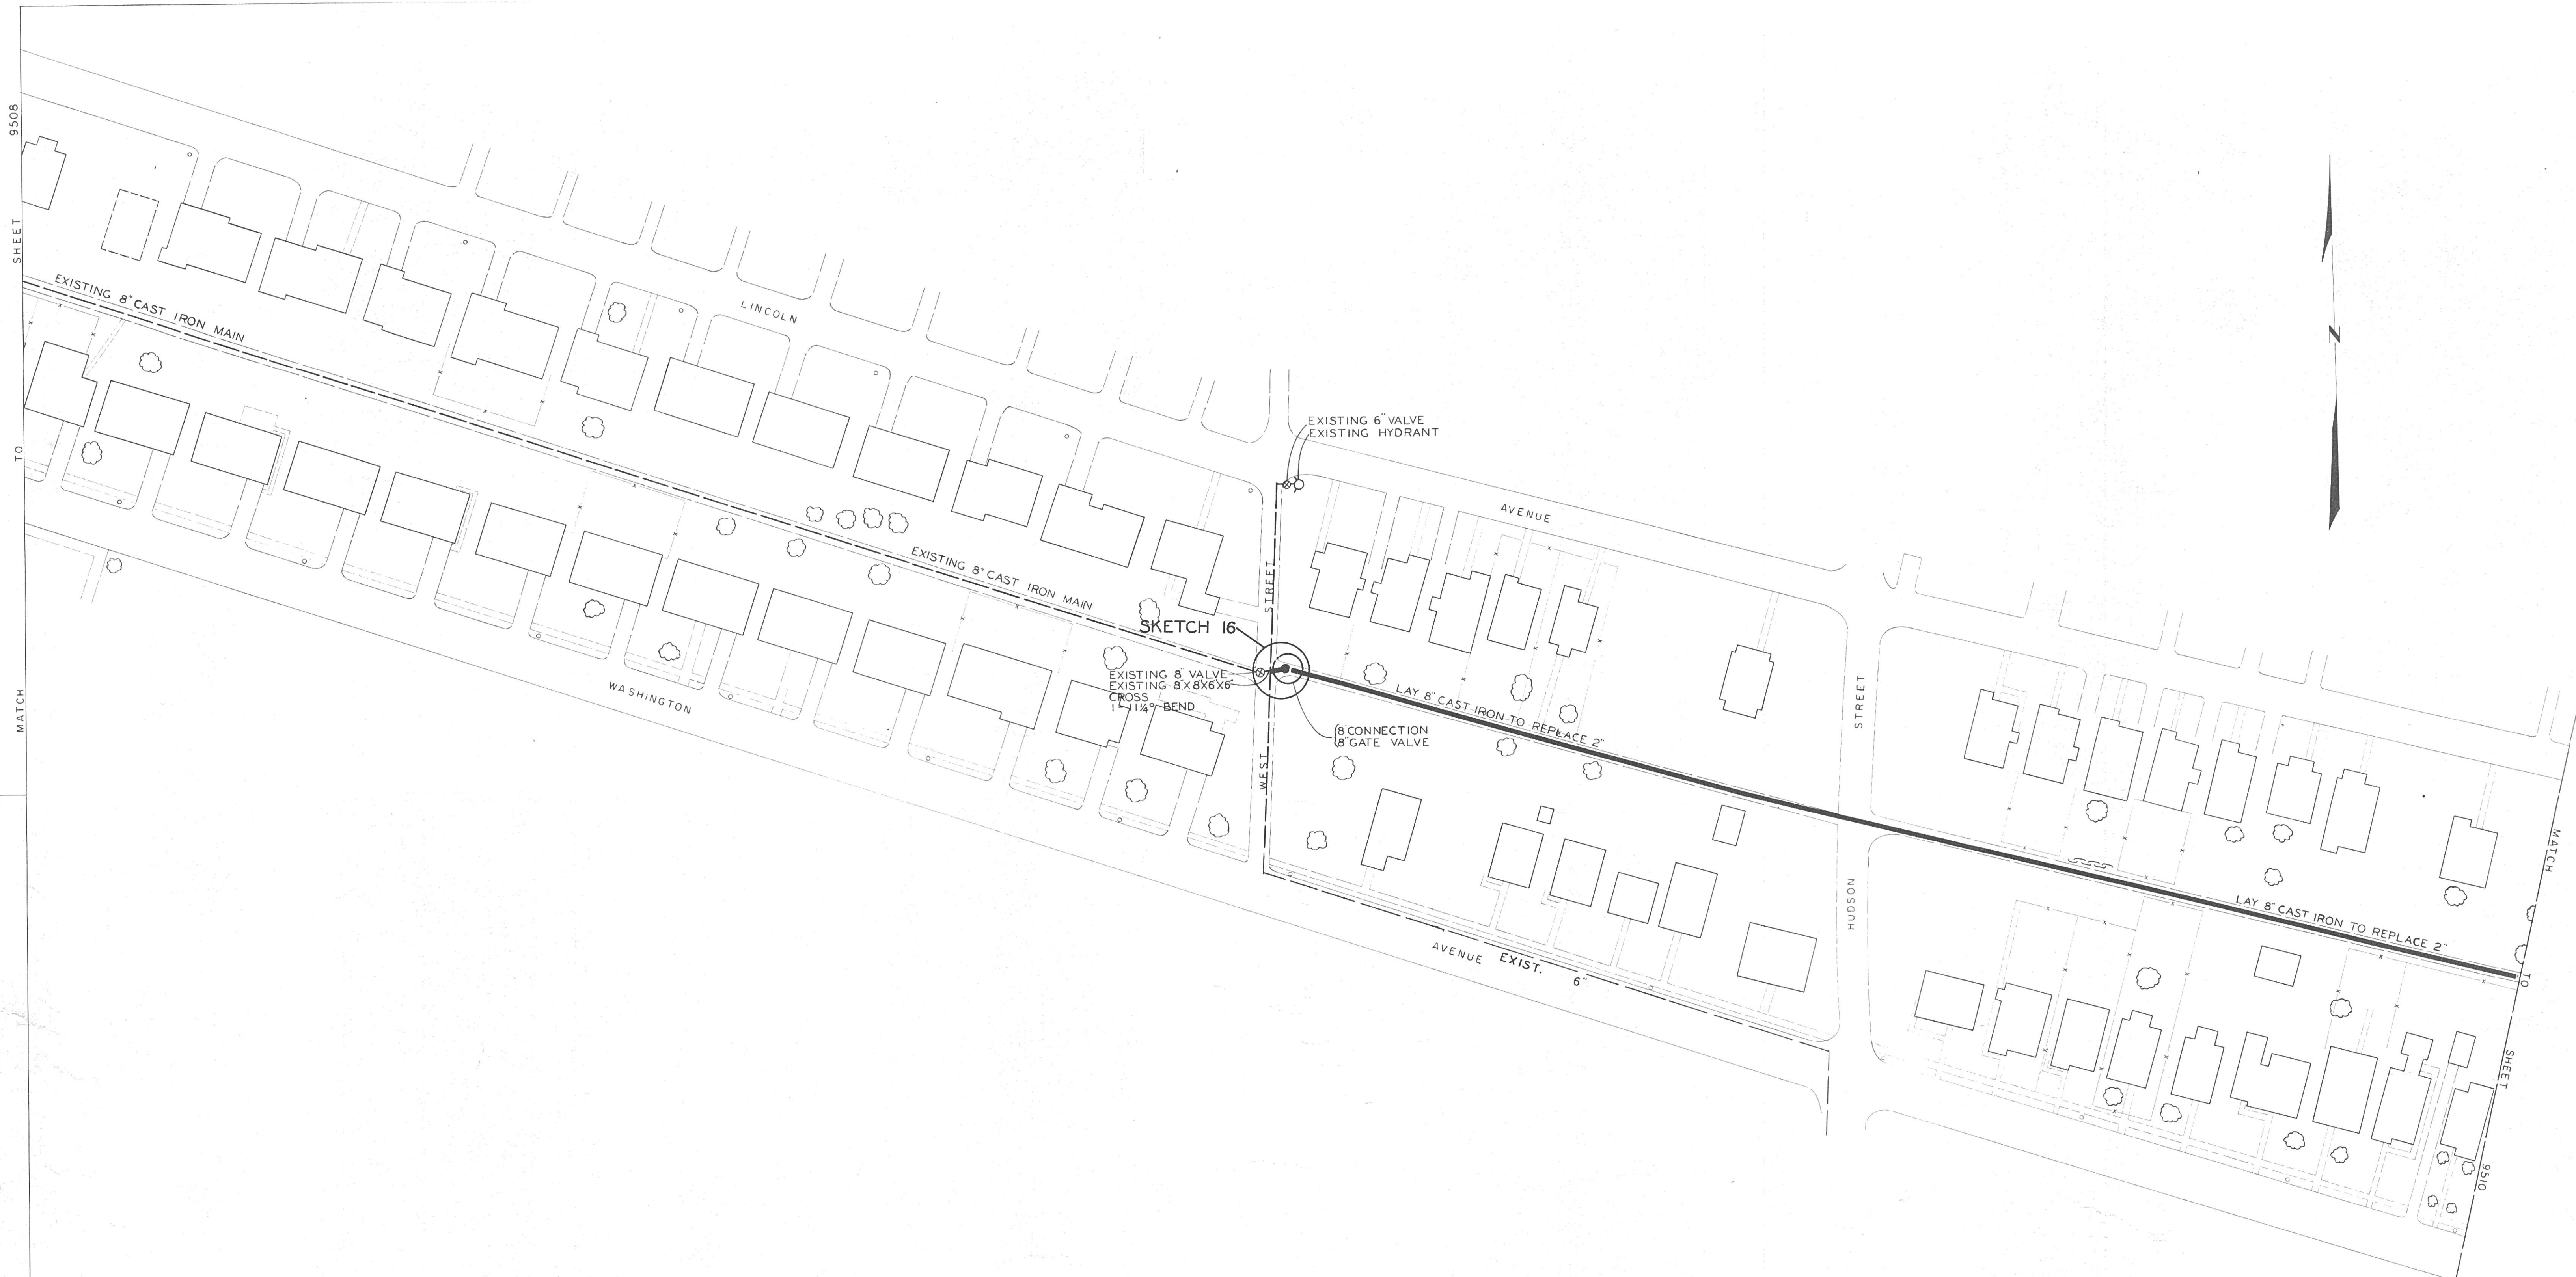

NO	4-64	AS BUILT
DISCRIPTION		
CITY OF SAINT ALBANS		
MUNICIPAL UTILITY COMMISSION		
KANAWHA COUNTY WEST VIRGINIA		
PROPOSED IMPROVEMENTS		
WATER DISTRIBUTION SYSTEM		
APW-WVA-I6G		
DATE	SCALE	URWS NO
MARCH 1963	1" = 50'	9509-1
KELLEY, GIDLEY & STAUB INC. CONSULTING ENGINEERS		
CHARLESTON, WEST VIRGINIA		