


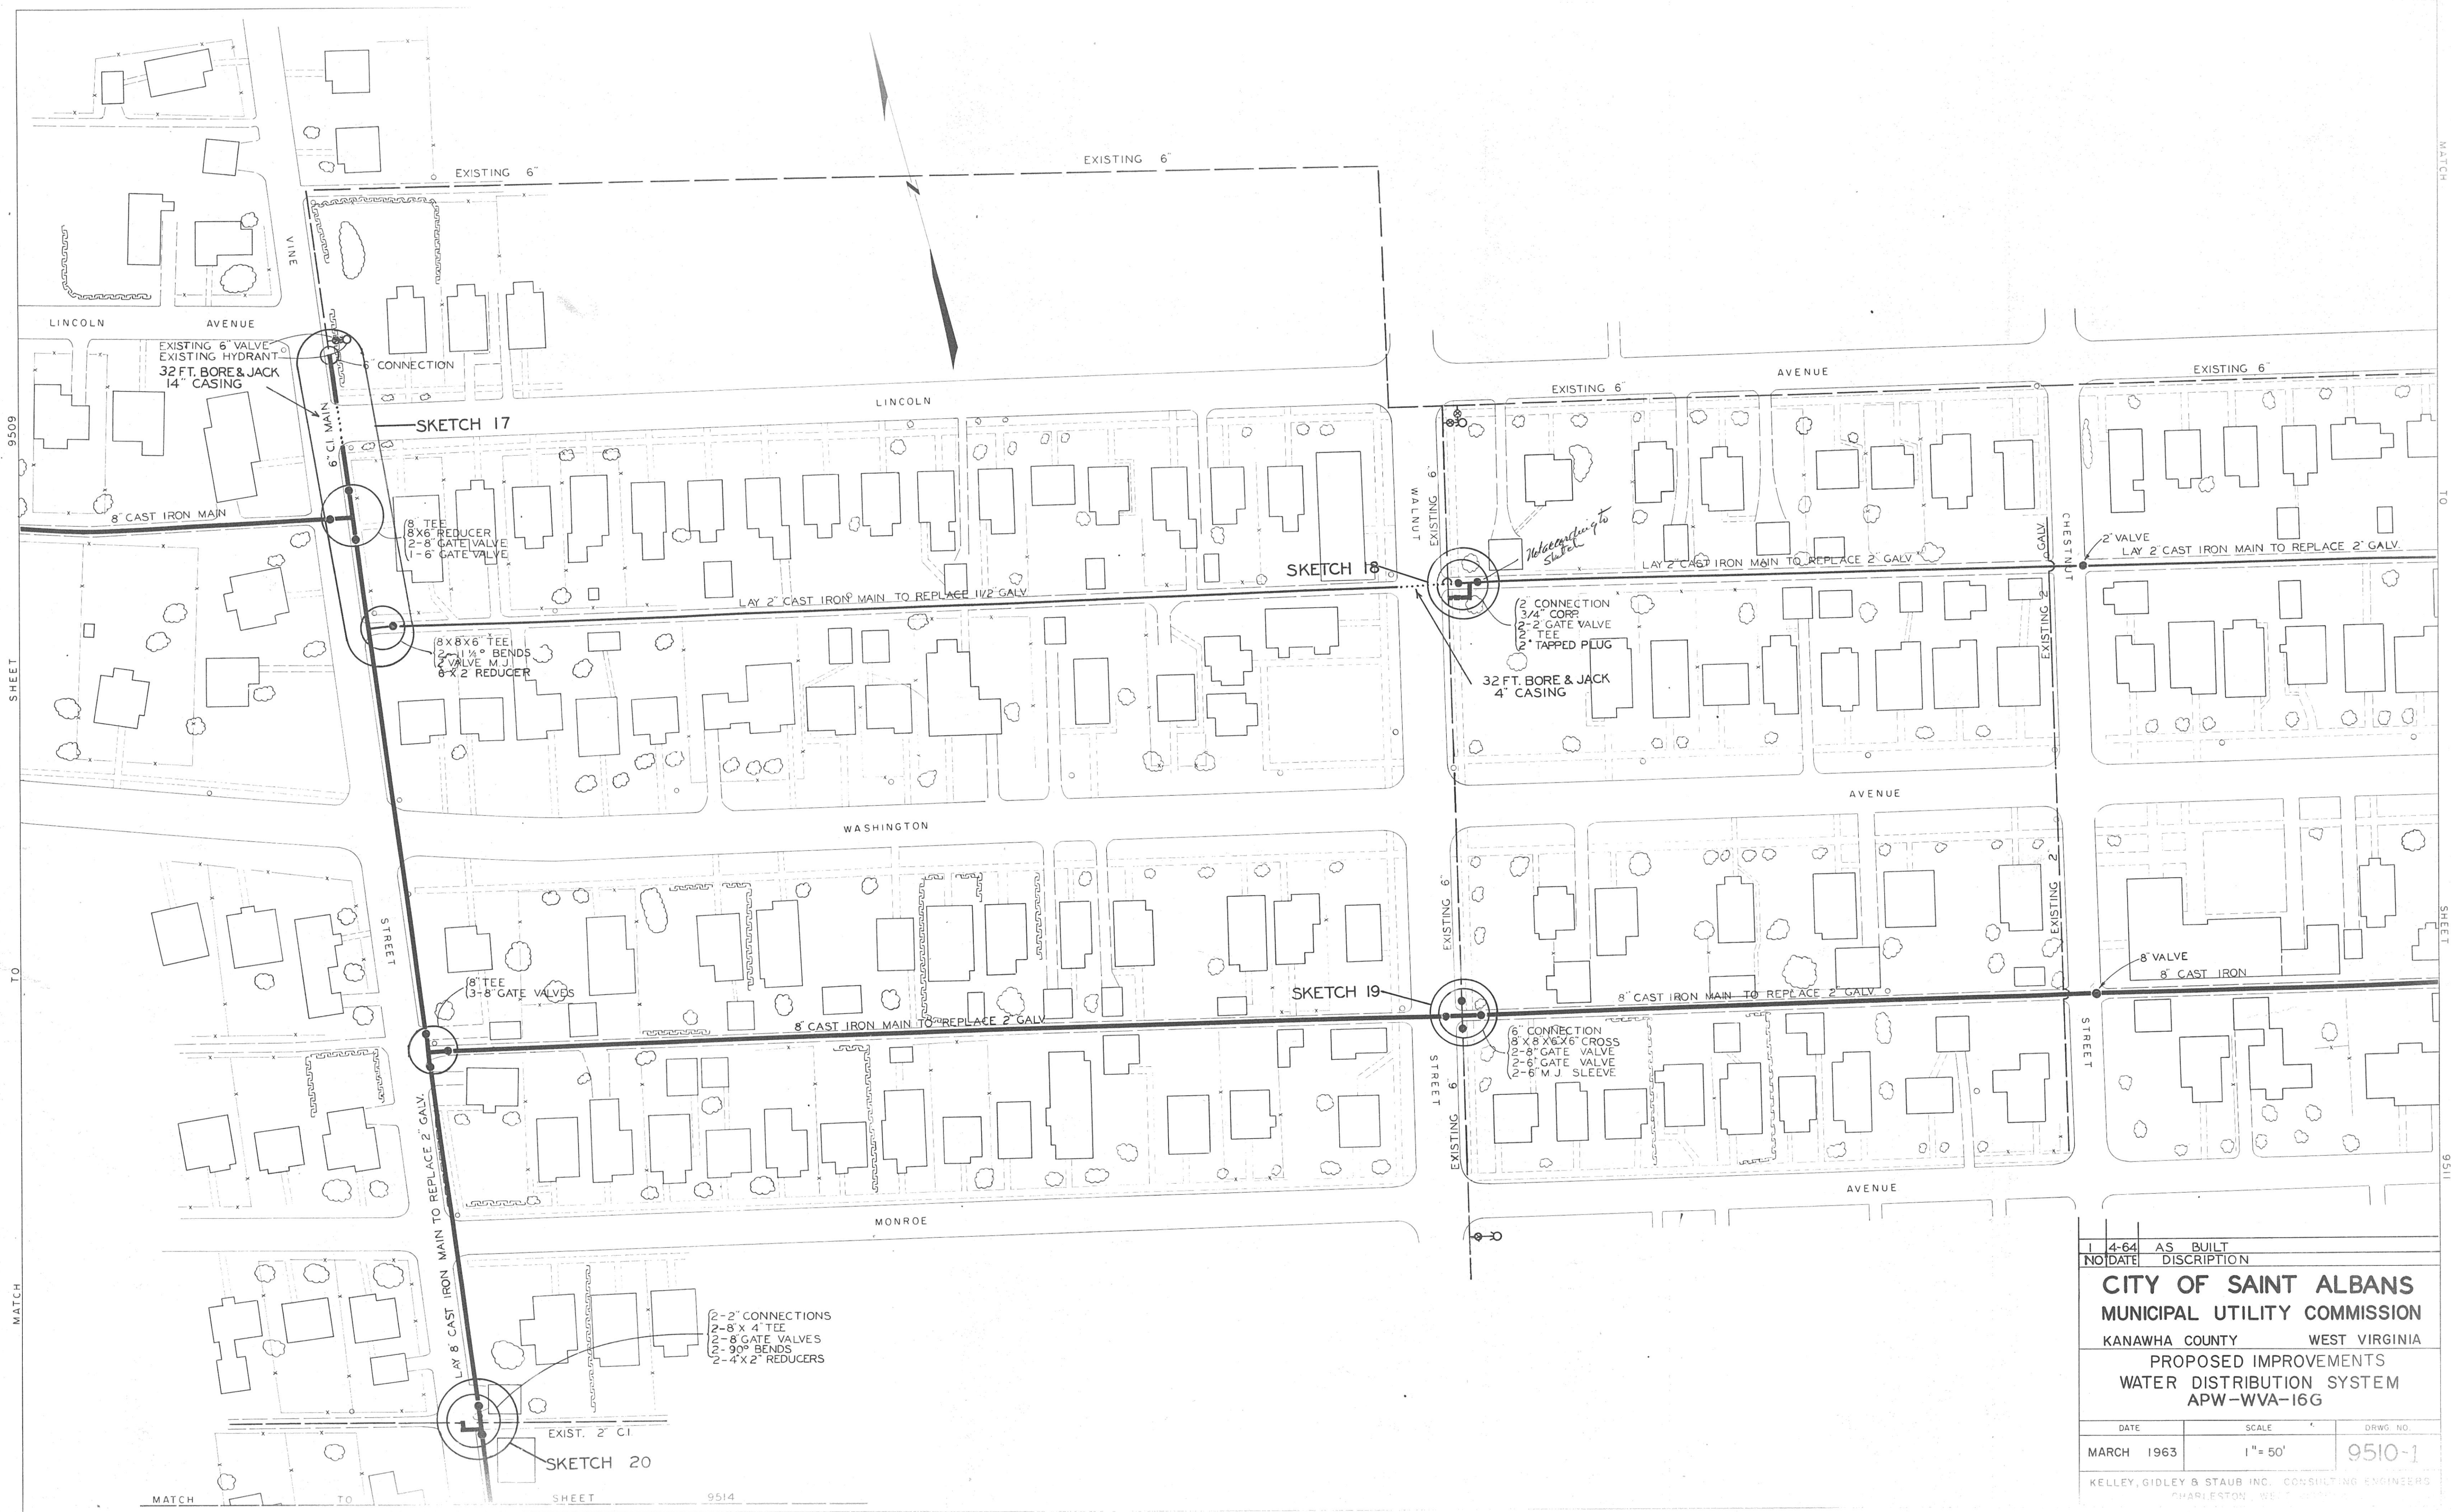

1-4-64	AS BUILT	
NO DATE	DISCUSSION	
CITY OF SAINT ALBANS		
MUNICIPAL UTILITY COMMISSION		
KANAWHA COUNTY	WEST VIRGINIA	
PROPOSED IMPROVEMENTS		
WATER DISTRIBUTION SYSTEM		
APW-WVA-16G		
DATE	SCALE	DRWG. NO.
MARCH 1963	1" = 50'	9510-1
KELLEY, GIDLEY & STAUB INC. CONSULTING ENGINEERS		
CHARLESTON, WEST VIRGINIA		