


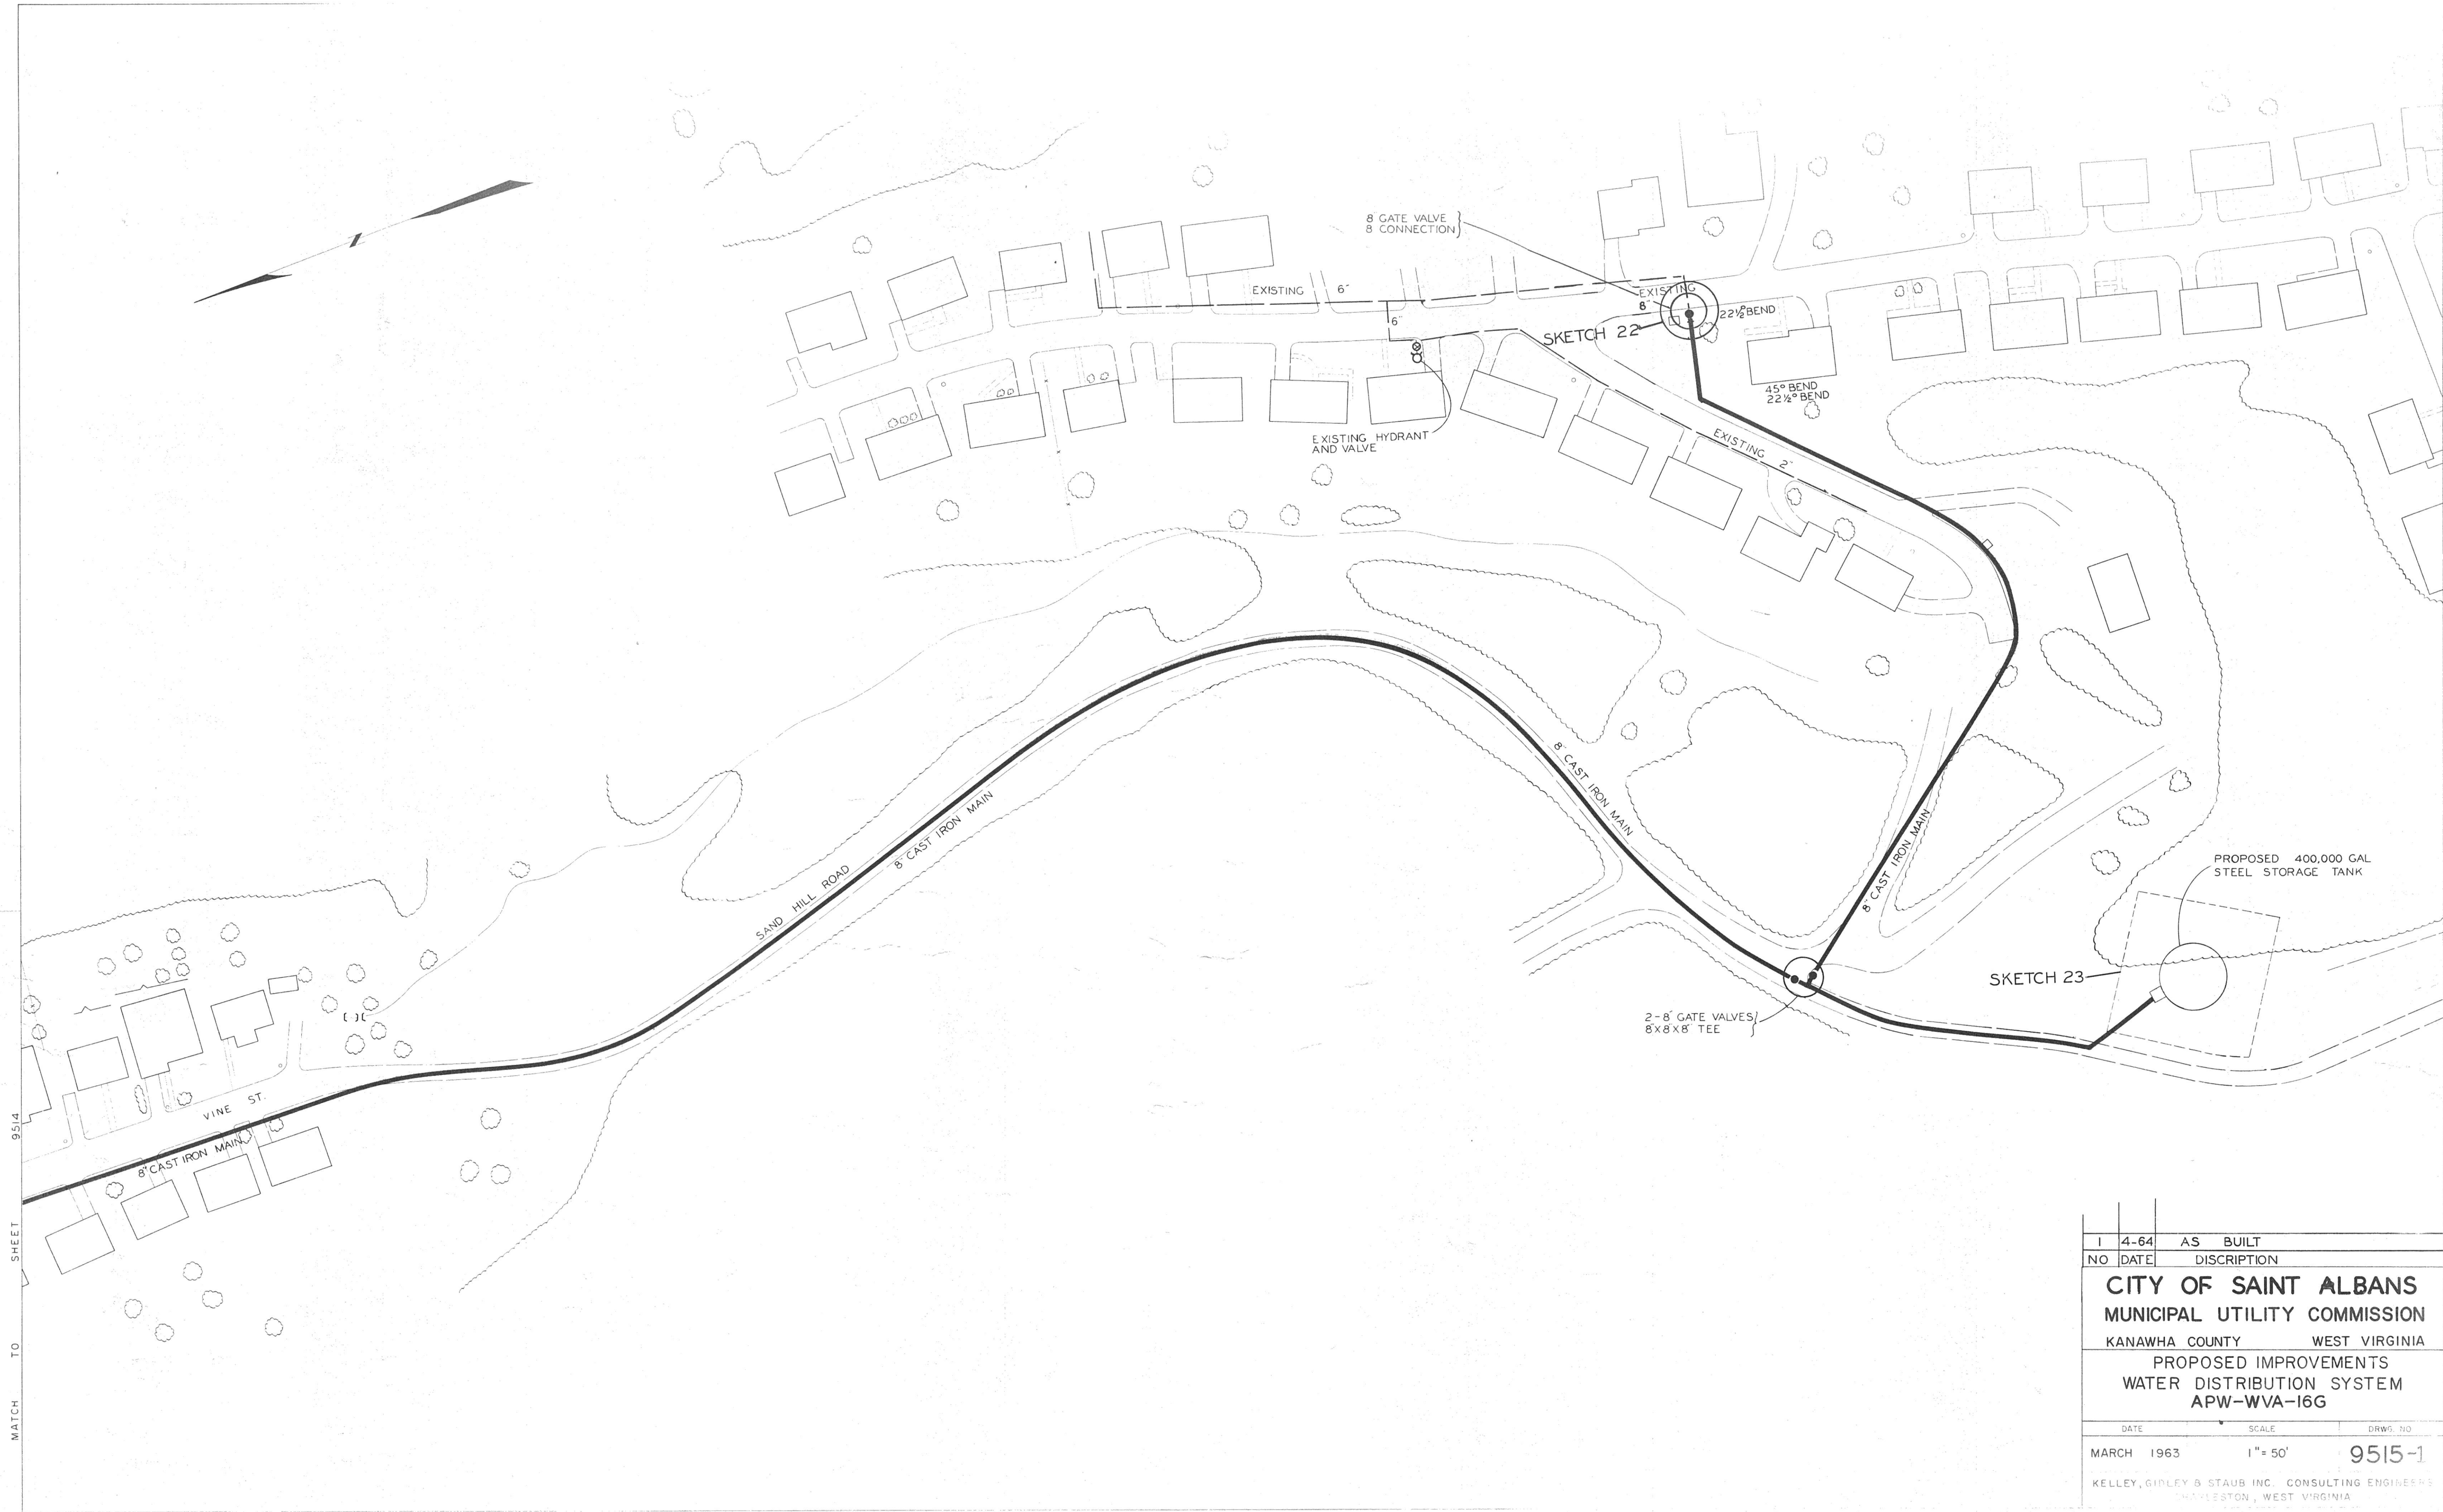

1	4-64	AS BUILT
NO	DATE	DISCRIPTION
CITY OF SAINT ALBANS		
MUNICIPAL UTILITY COMMISSION		
KANAWHA COUNTY		WEST VIRGINIA
PROPOSED IMPROVEMENTS		
WATER DISTRIBUTION SYSTEM		
APW-WVA-I6G		
DATE	SCALE	DRWG. NO.
MARCH 1963	1" = 50'	9515-1
KELLEY, GIRDLEY & STAUB INC. CONSULTING ENGINEERS		
CHARLESTON, WEST VIRGINIA		