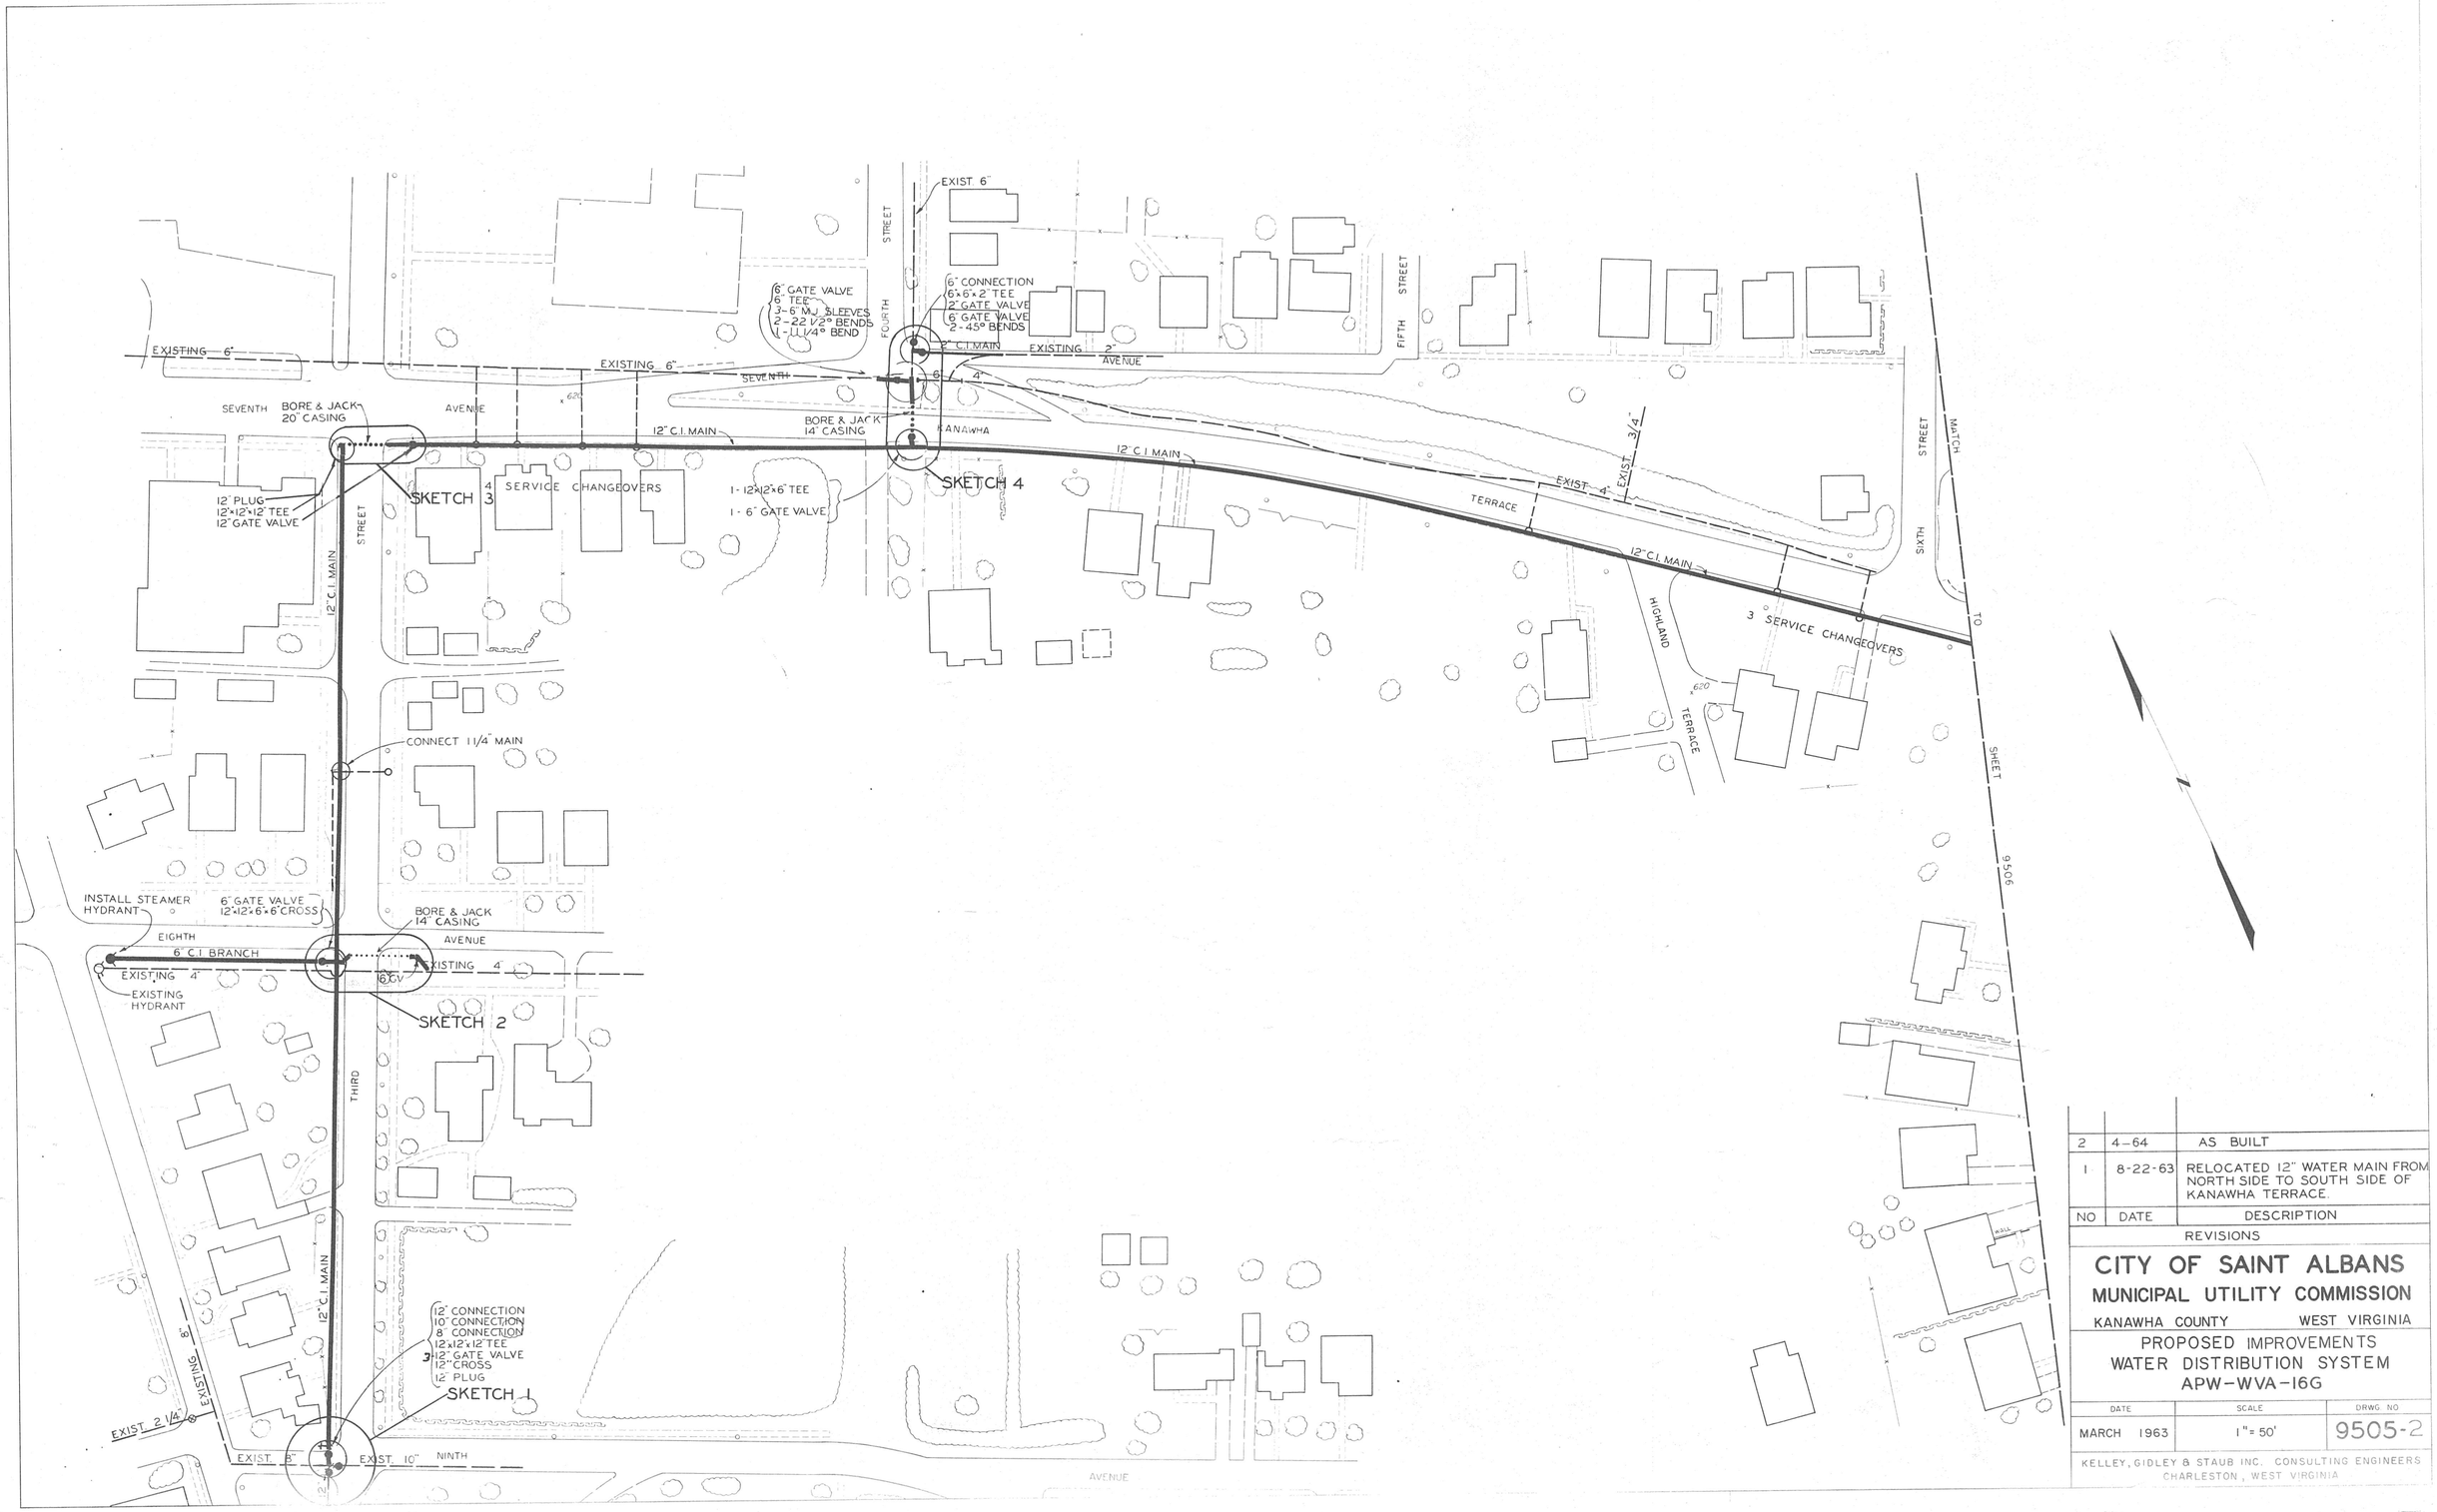

NO	DATE	DESCRIPTION
2	4-64	AS BUILT
1	8-22-63	RELOCATED 12" WATER MAIN FROM NORTH SIDE TO SOUTH SIDE OF KANAWHA TERRACE.

REVISIONS

CITY OF SAINT ALBANS
MUNICIPAL UTILITY COMMISSION

KANAWHA COUNTY WEST VIRGINIA

PROPOSED IMPROVEMENTS
WATER DISTRIBUTION SYSTEM
APW-WVA-16G

DATE	SCALE	DRWG. NO
MARCH 1963	1" = 50'	9505-2

KELLEY, GIDLEY & STAUB INC. CONSULTING ENGINEERS
CHARLESTON, WEST VIRGINIA

PREPARED BY AMERICAN AIR SURV