


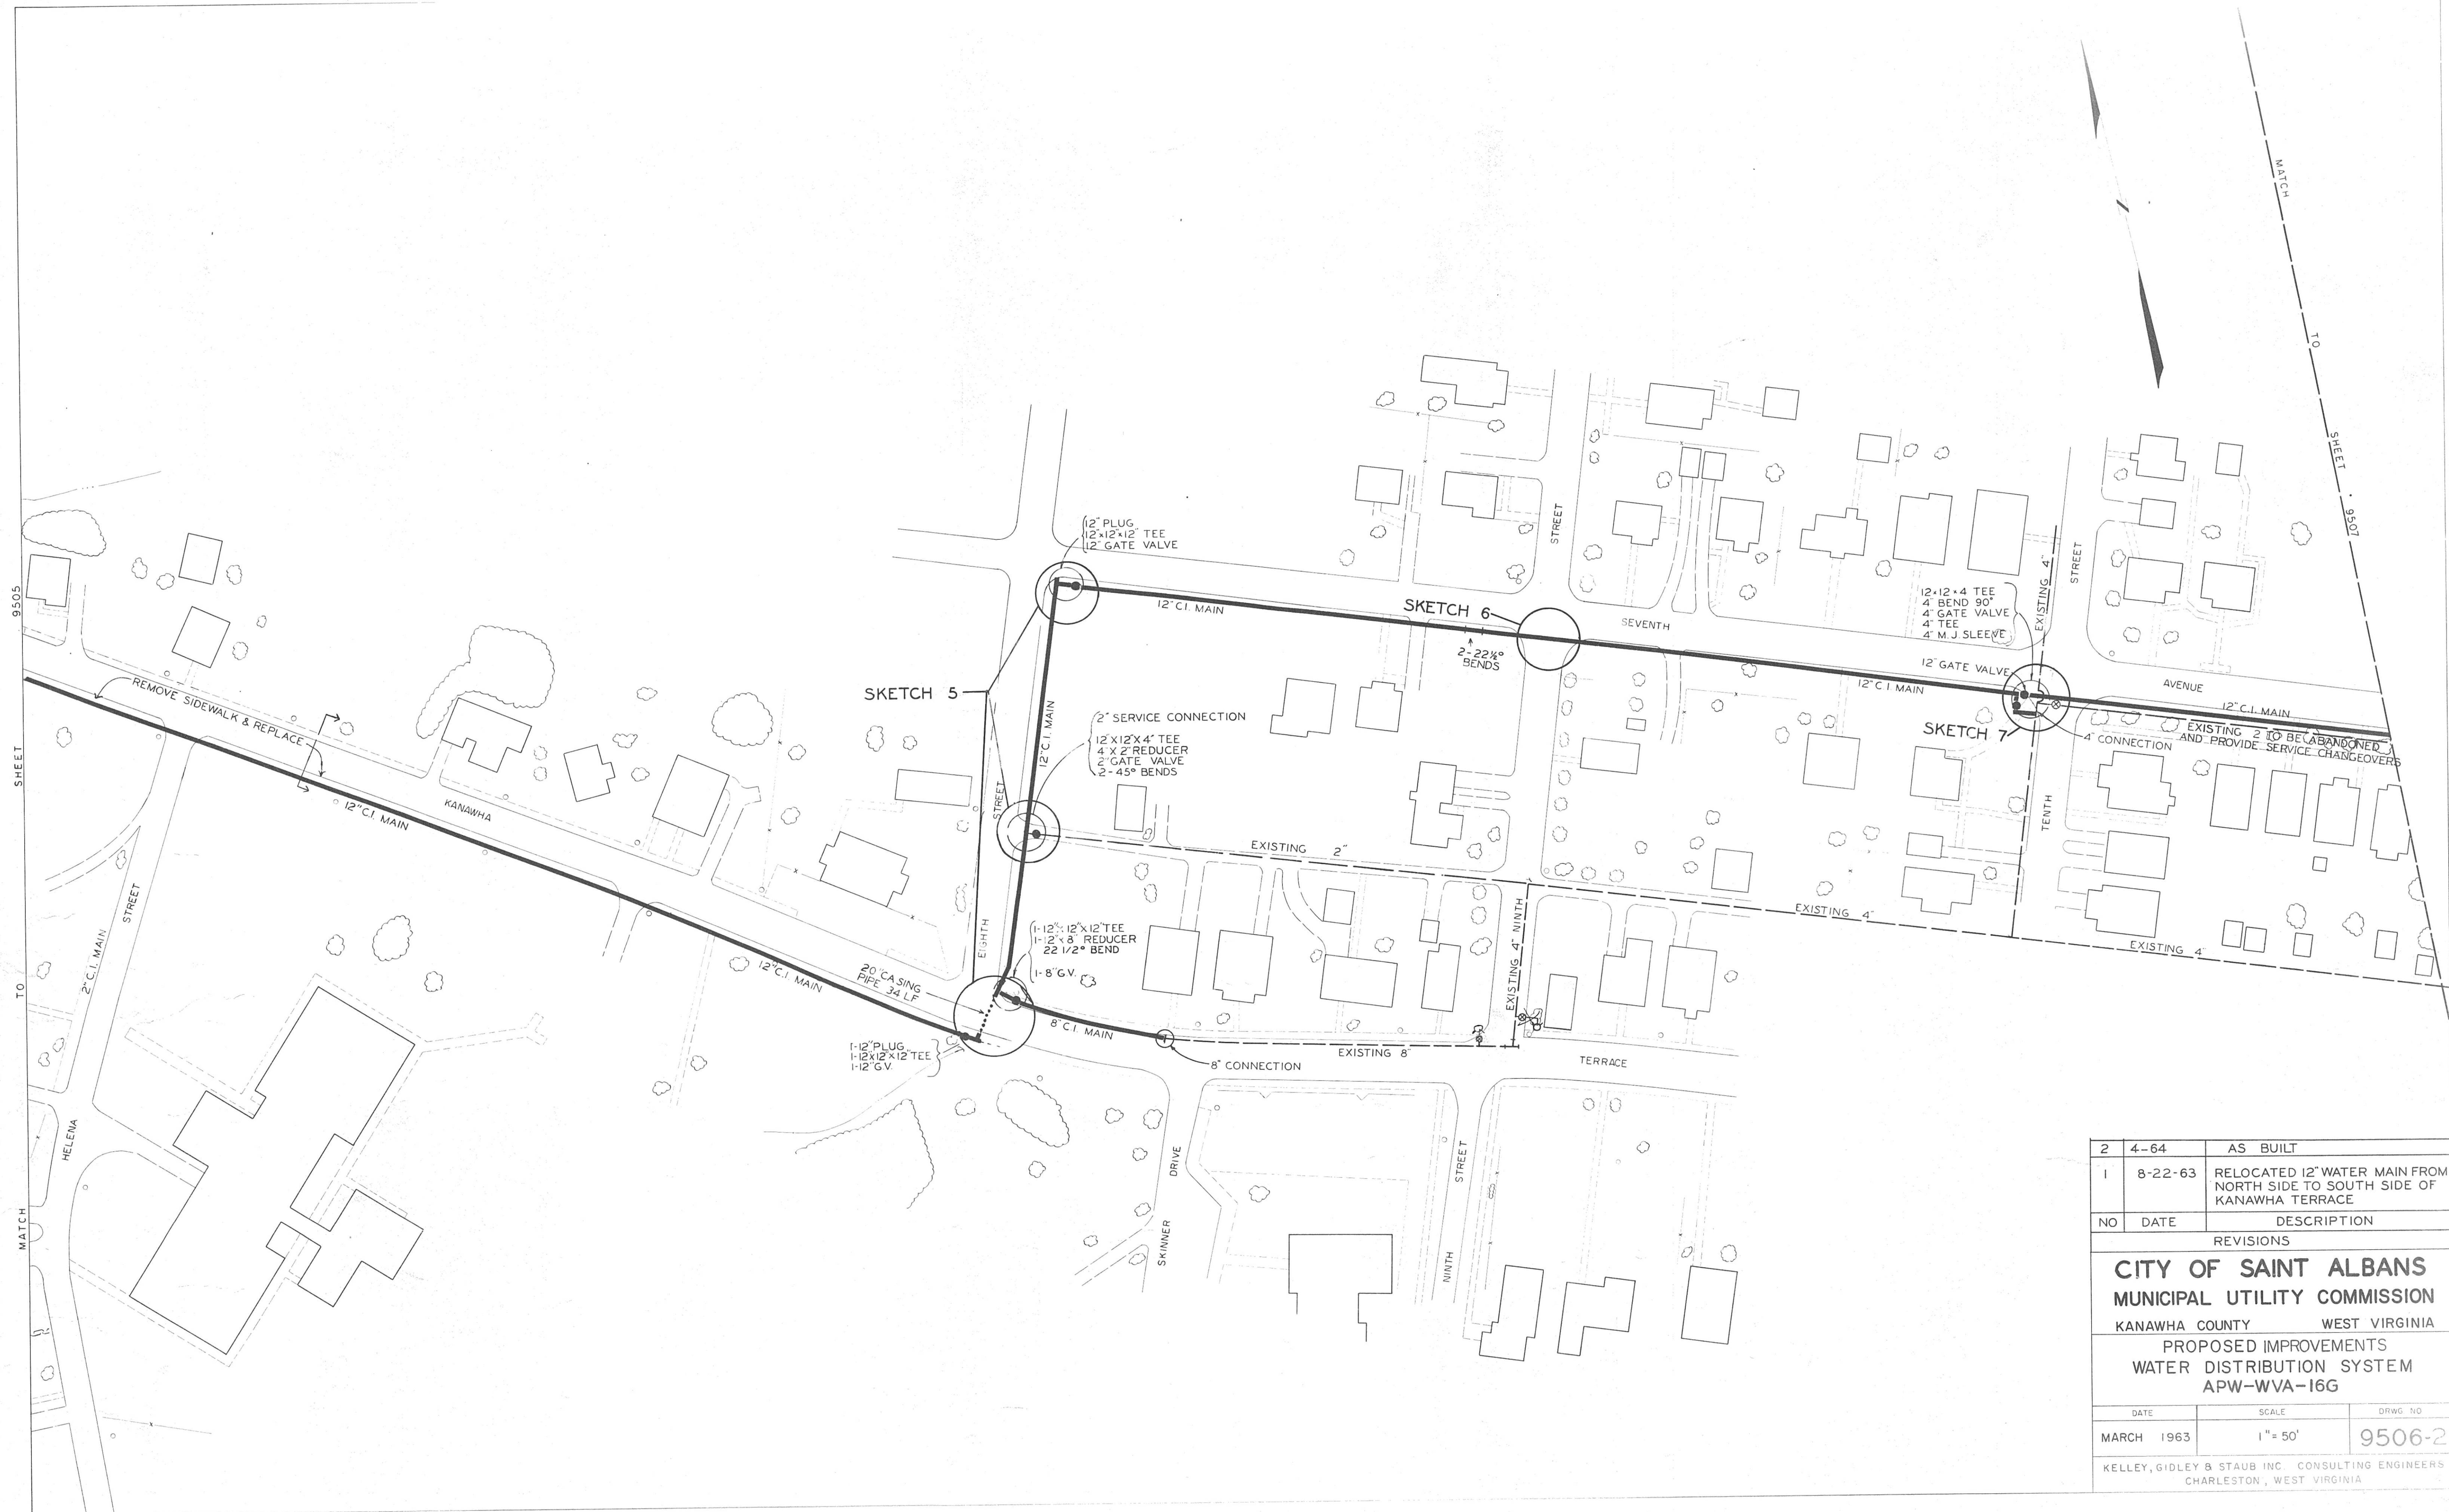

2	4-64	AS BUILT
1	8-22-63	RELOCATED 12" WATER MAIN FROM NORTH SIDE TO SOUTH SIDE OF KANAWHA TERRACE
NO	DATE	DESCRIPTION
REVISIONS		
CITY OF SAINT ALBANS		
MUNICIPAL UTILITY COMMISSION		
KANAWHA COUNTY WEST VIRGINIA		
PROPOSED IMPROVEMENTS		
WATER DISTRIBUTION SYSTEM		
APW-WVA-16G		
DATE	SCALE	DRWG NO.
MARCH 1963	1" = 50'	9506-2
KELLEY, GIDLEY & STAUB INC. CONSULTING ENGINEERS CHARLESTON, WEST VIRGINIA		