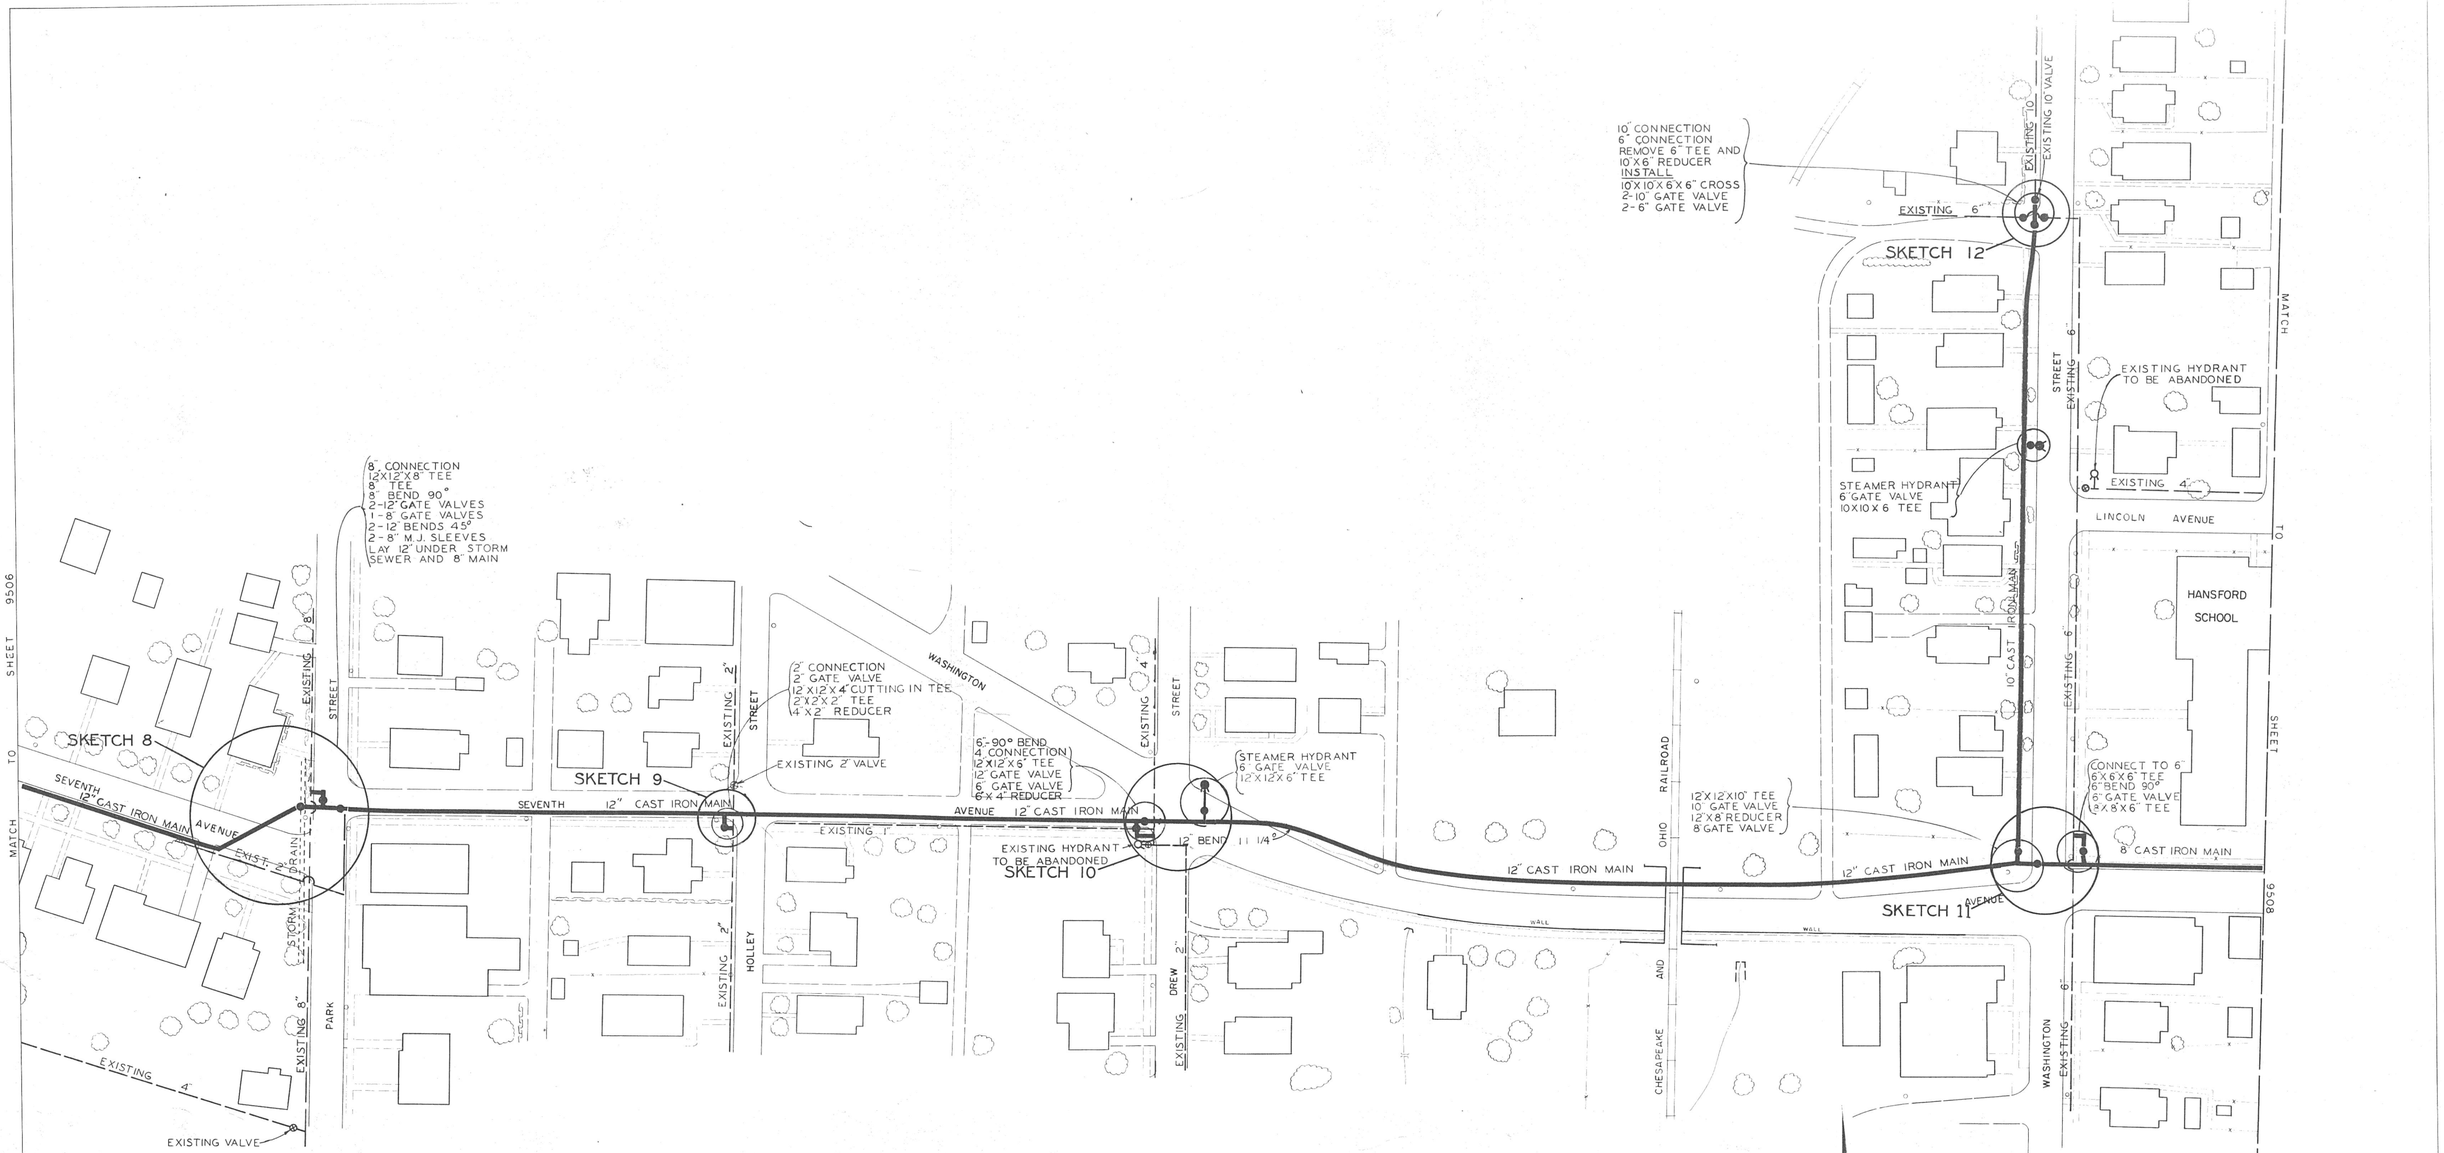

NO	DATE	DISCRIPTION
1	4-64	AS BUILT

CITY OF SAINT ALBANS
MUNICIPAL UTILITY COMMISSION

KANAWHA COUNTY WEST VIRGINIA

PROPOSED IMPROVEMENTS
WATER DISTRIBUTION SYSTEM
APW-WVA-16G

DATE	SCALE	DRWG. NO.
MARCH 1963	1" = 50'	9507-1

KELLEY, GIDLEY & STAUB INC. CONSULTING ENGINEERS
CHARLESTON, WEST VIRGINIA

PREPARED BY AMERICAN AIR SURVEYS, INC.