Tabled

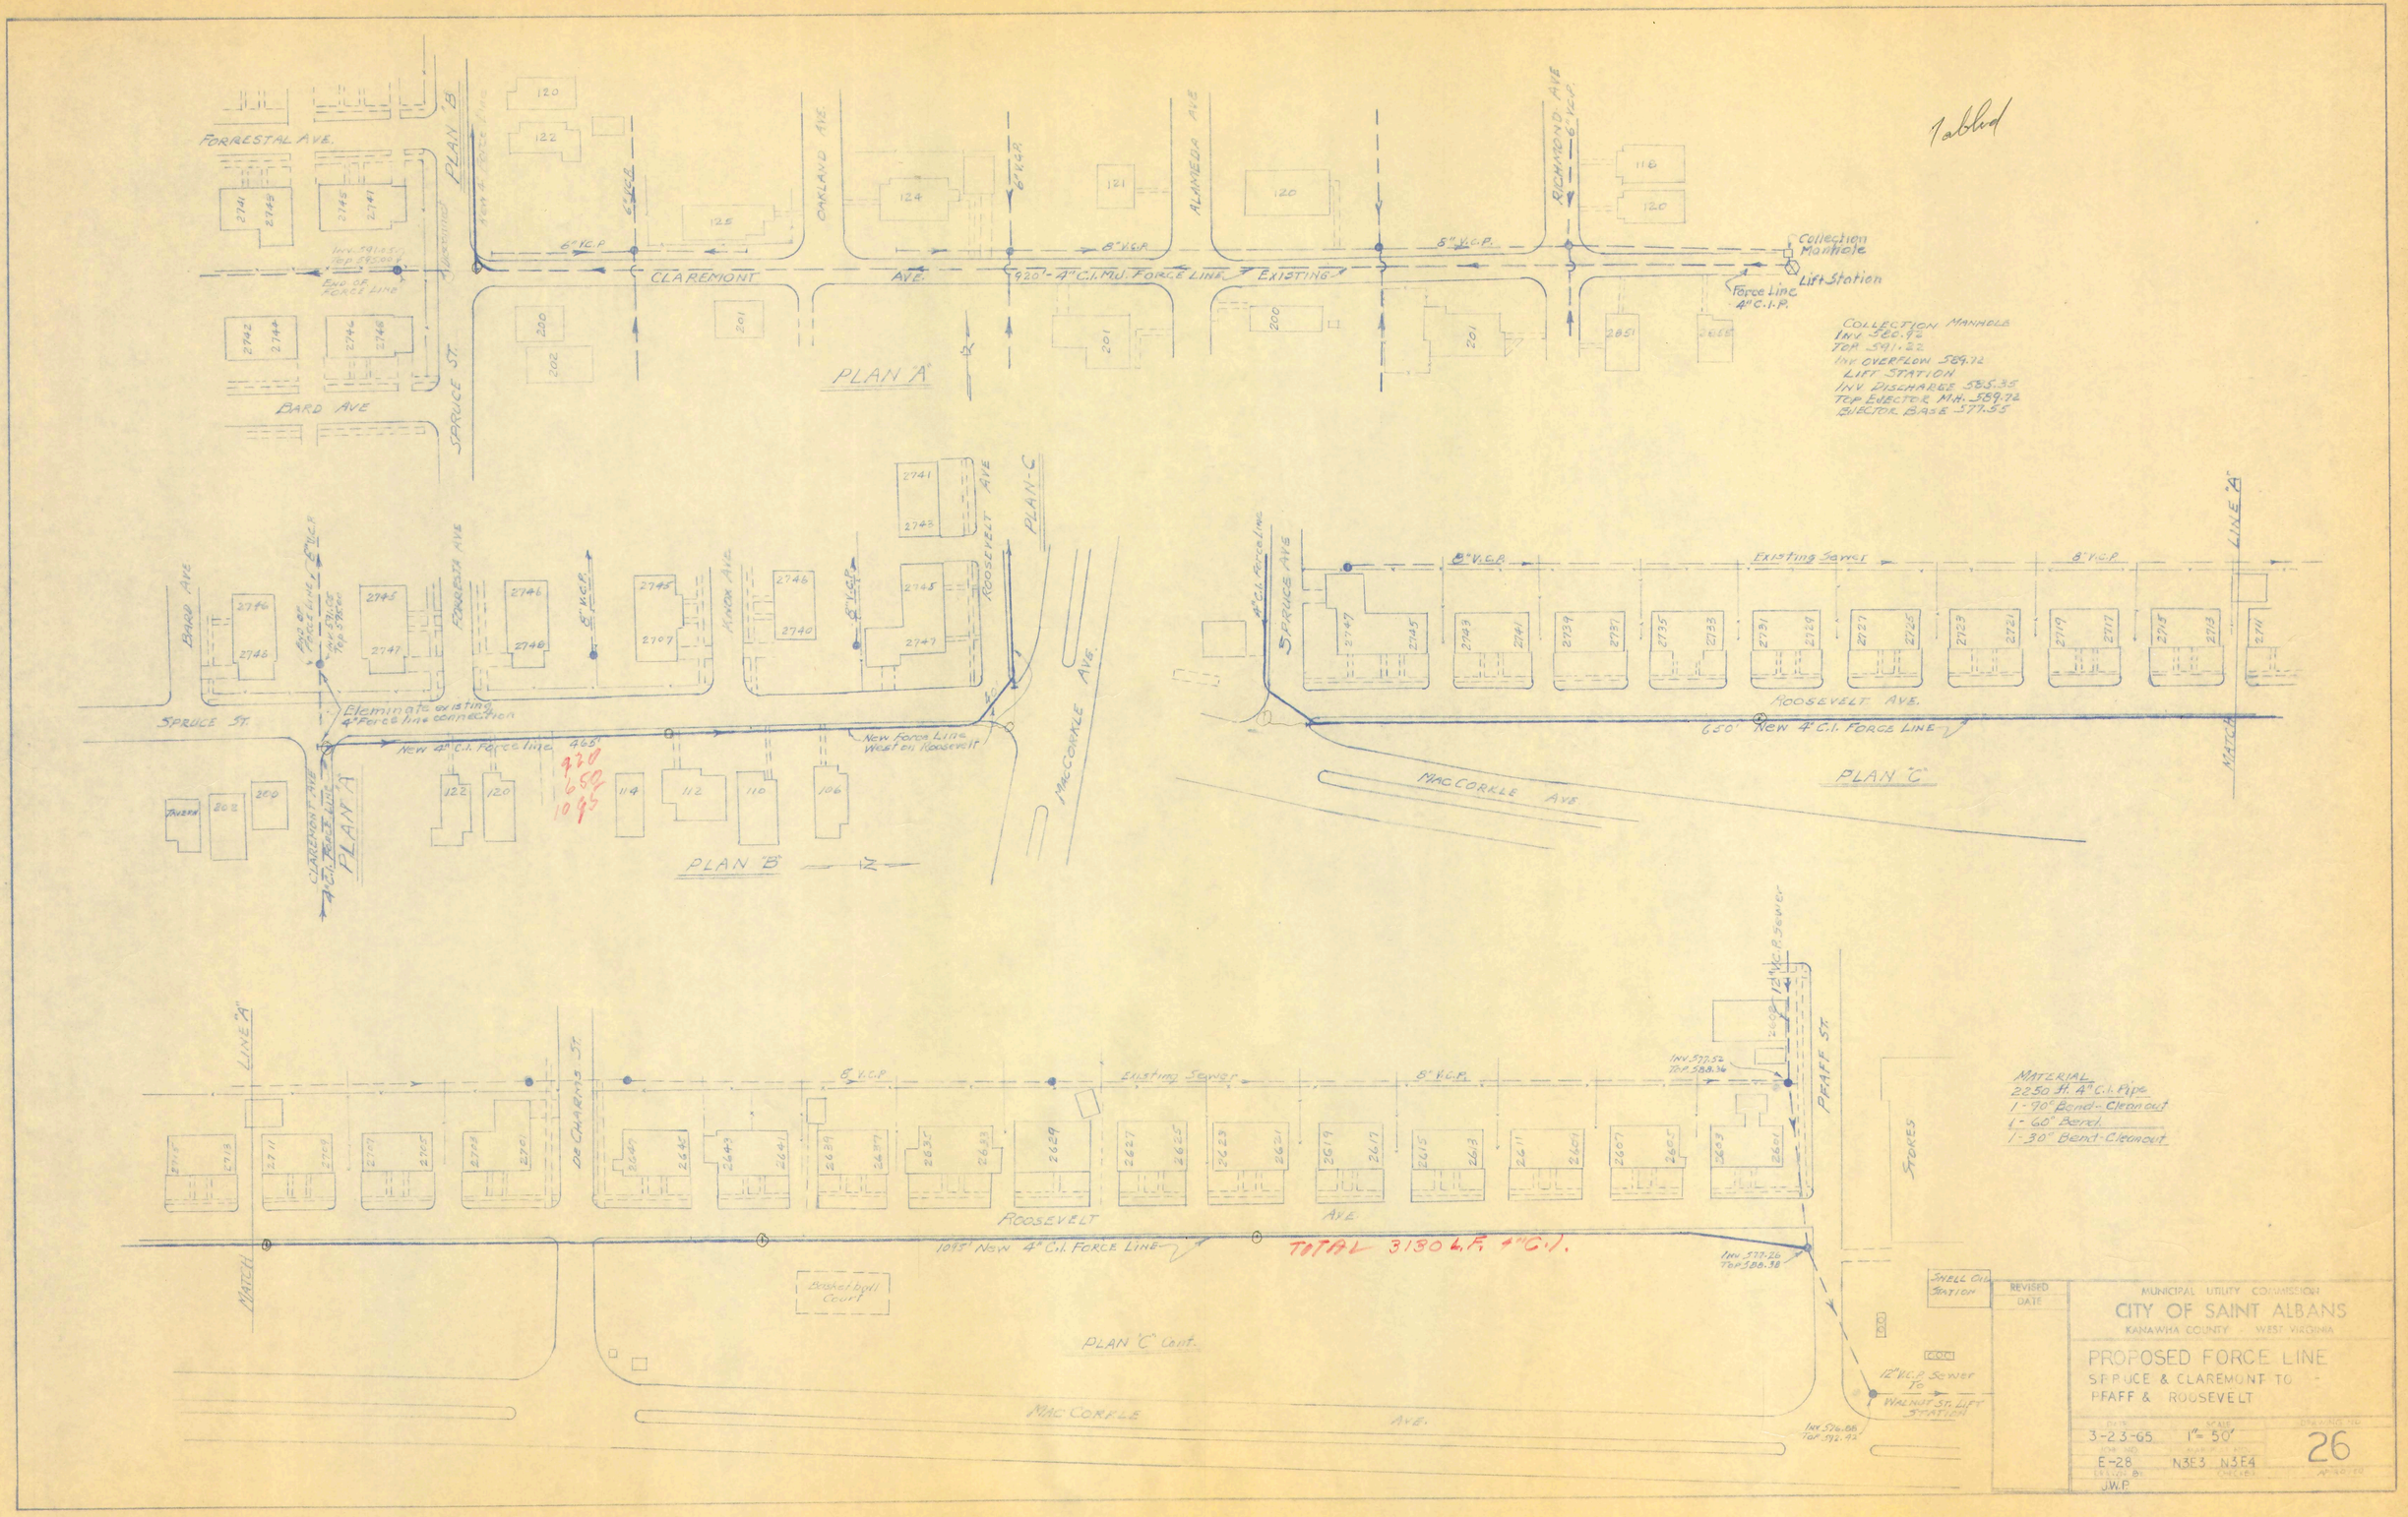
FORRESTAL AVE.
PLAN "B"
Existing Force Line
Inv. 591.05
Top 595.00
End of Force Line
BARD AVE
SPRUCE ST.
CLAREMONT AVE.
OAKLAND AVE.
ALAMEDA AVE
RICHMOND AVE
6" V.C.P.
8" V.C.P.
920' - 4" C.I. MU. FORCE LINE EXISTING
PLAN "A"
Collection Manhole
Lift Station
Force Line 4" C.I.P.
COLLECTION MANHOLE
INV. 582.92
TOP 591.22
INV. OVERFLOW 589.72
LIFT STATION
INV. DISCHARGE 585.35
TOP EJECTOR M.H. 589.72
EJECTOR BASE 577.55
Eleminate existing 4" Force line connection
New 4" C.I. Force line 468'
New Force Line West on Roosevelt
FORRESTA AVE
KNOX AVE.
ROOSEVELT AVE
PLAN "C"
MACCORKLE AVE.
PLAN "B"
CLAREMONT AVE
4" C.I. Force line
PLAN "A"
4" C.I. Force line
SPRUCE AVE
Existing Sewer
ROOSEVELT AVE.
650' New 4" C.I. FORCE LINE
MACCORKLE AVE
PLAN "C"
MATCH LINE "A"
N3E3
N2E3
H2E4
LINE "A"
DE CHARNES ST.
Existing Sewer
ROOSEVELT AVE
1095' New 4" C.I. FORCE LINE
TOTAL 3130 L.F. 4" C.I.
Basketball Court
PLAN "C" Cont.
MAC CORKLE AVE.
12" V.C.P. Sewer
Inv. 577.52
Top 588.36
PRAFF ST.
STOKES
Inv. 577.26
Top 588.38
SHELL OIL STATION
12" V.C.P. Sewer To WALNUT ST. LIFT STATION
Inv. 576.66
Top 592.42
MATERIAL
2250 ft. 4" C.I. Pipe
1 - 90° Bend - Clean out
1 - 60° Bend
1 - 30° Bend - Clean out
REVISED
DATE
MUNICIPAL UTILITY COMMISSION
CITY OF SAINT ALBANS
KANAWHA COUNTY - WEST VIRGINIA
PROPOSED FORCE LINE
SPRUCE & CLAREMONT TO PFAFF & ROOSEVELT
3-23-65
1" = 50'
E-28
N3E3 N3E4
J.W.F.
26