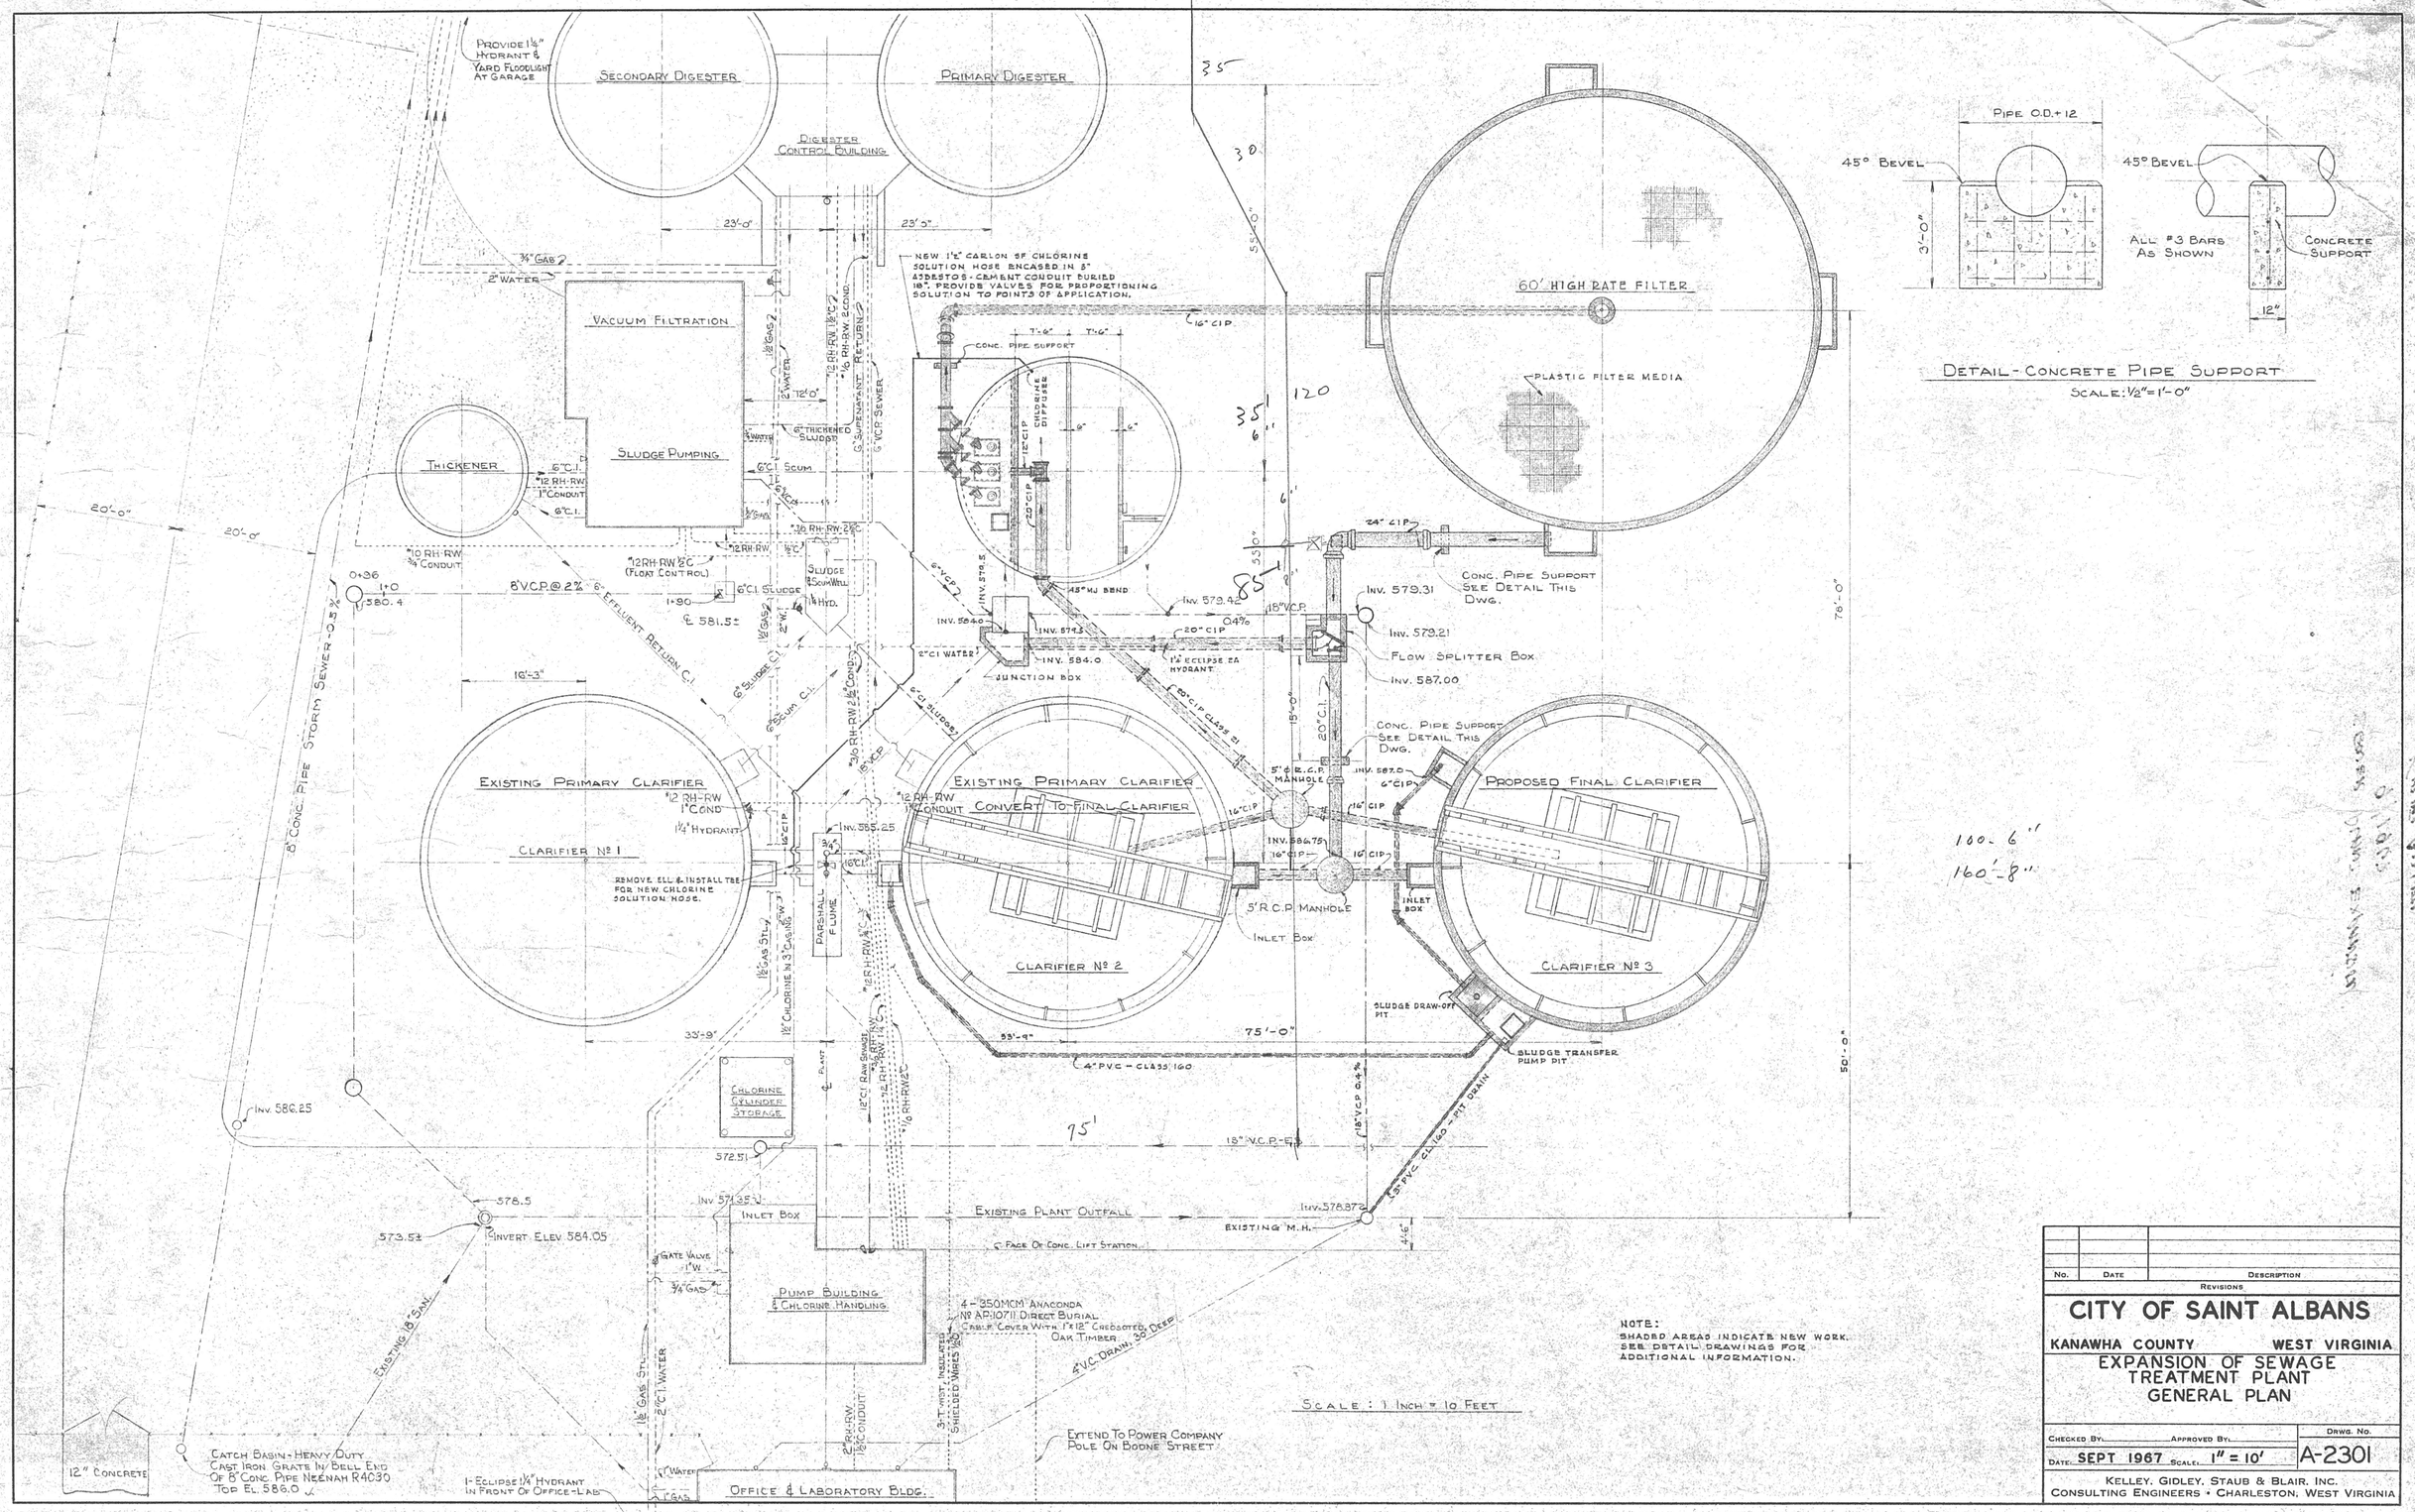

No.	Date	Description

Revisions

CITY OF SAINT ALBANS

KANAWHA COUNTY WEST VIRGINIA

EXPANSION OF SEWAGE TREATMENT PLANT GENERAL PLAN

Checked By: _____ Approved By: _____

Date: SEPT 1967 Scale: 1" = 10'

Drwg. No. A-2301

KELLEY, GIDLEY, STAUB & BLAIR, INC.
CONSULTING ENGINEERS • CHARLESTON, WEST VIRGINIA