


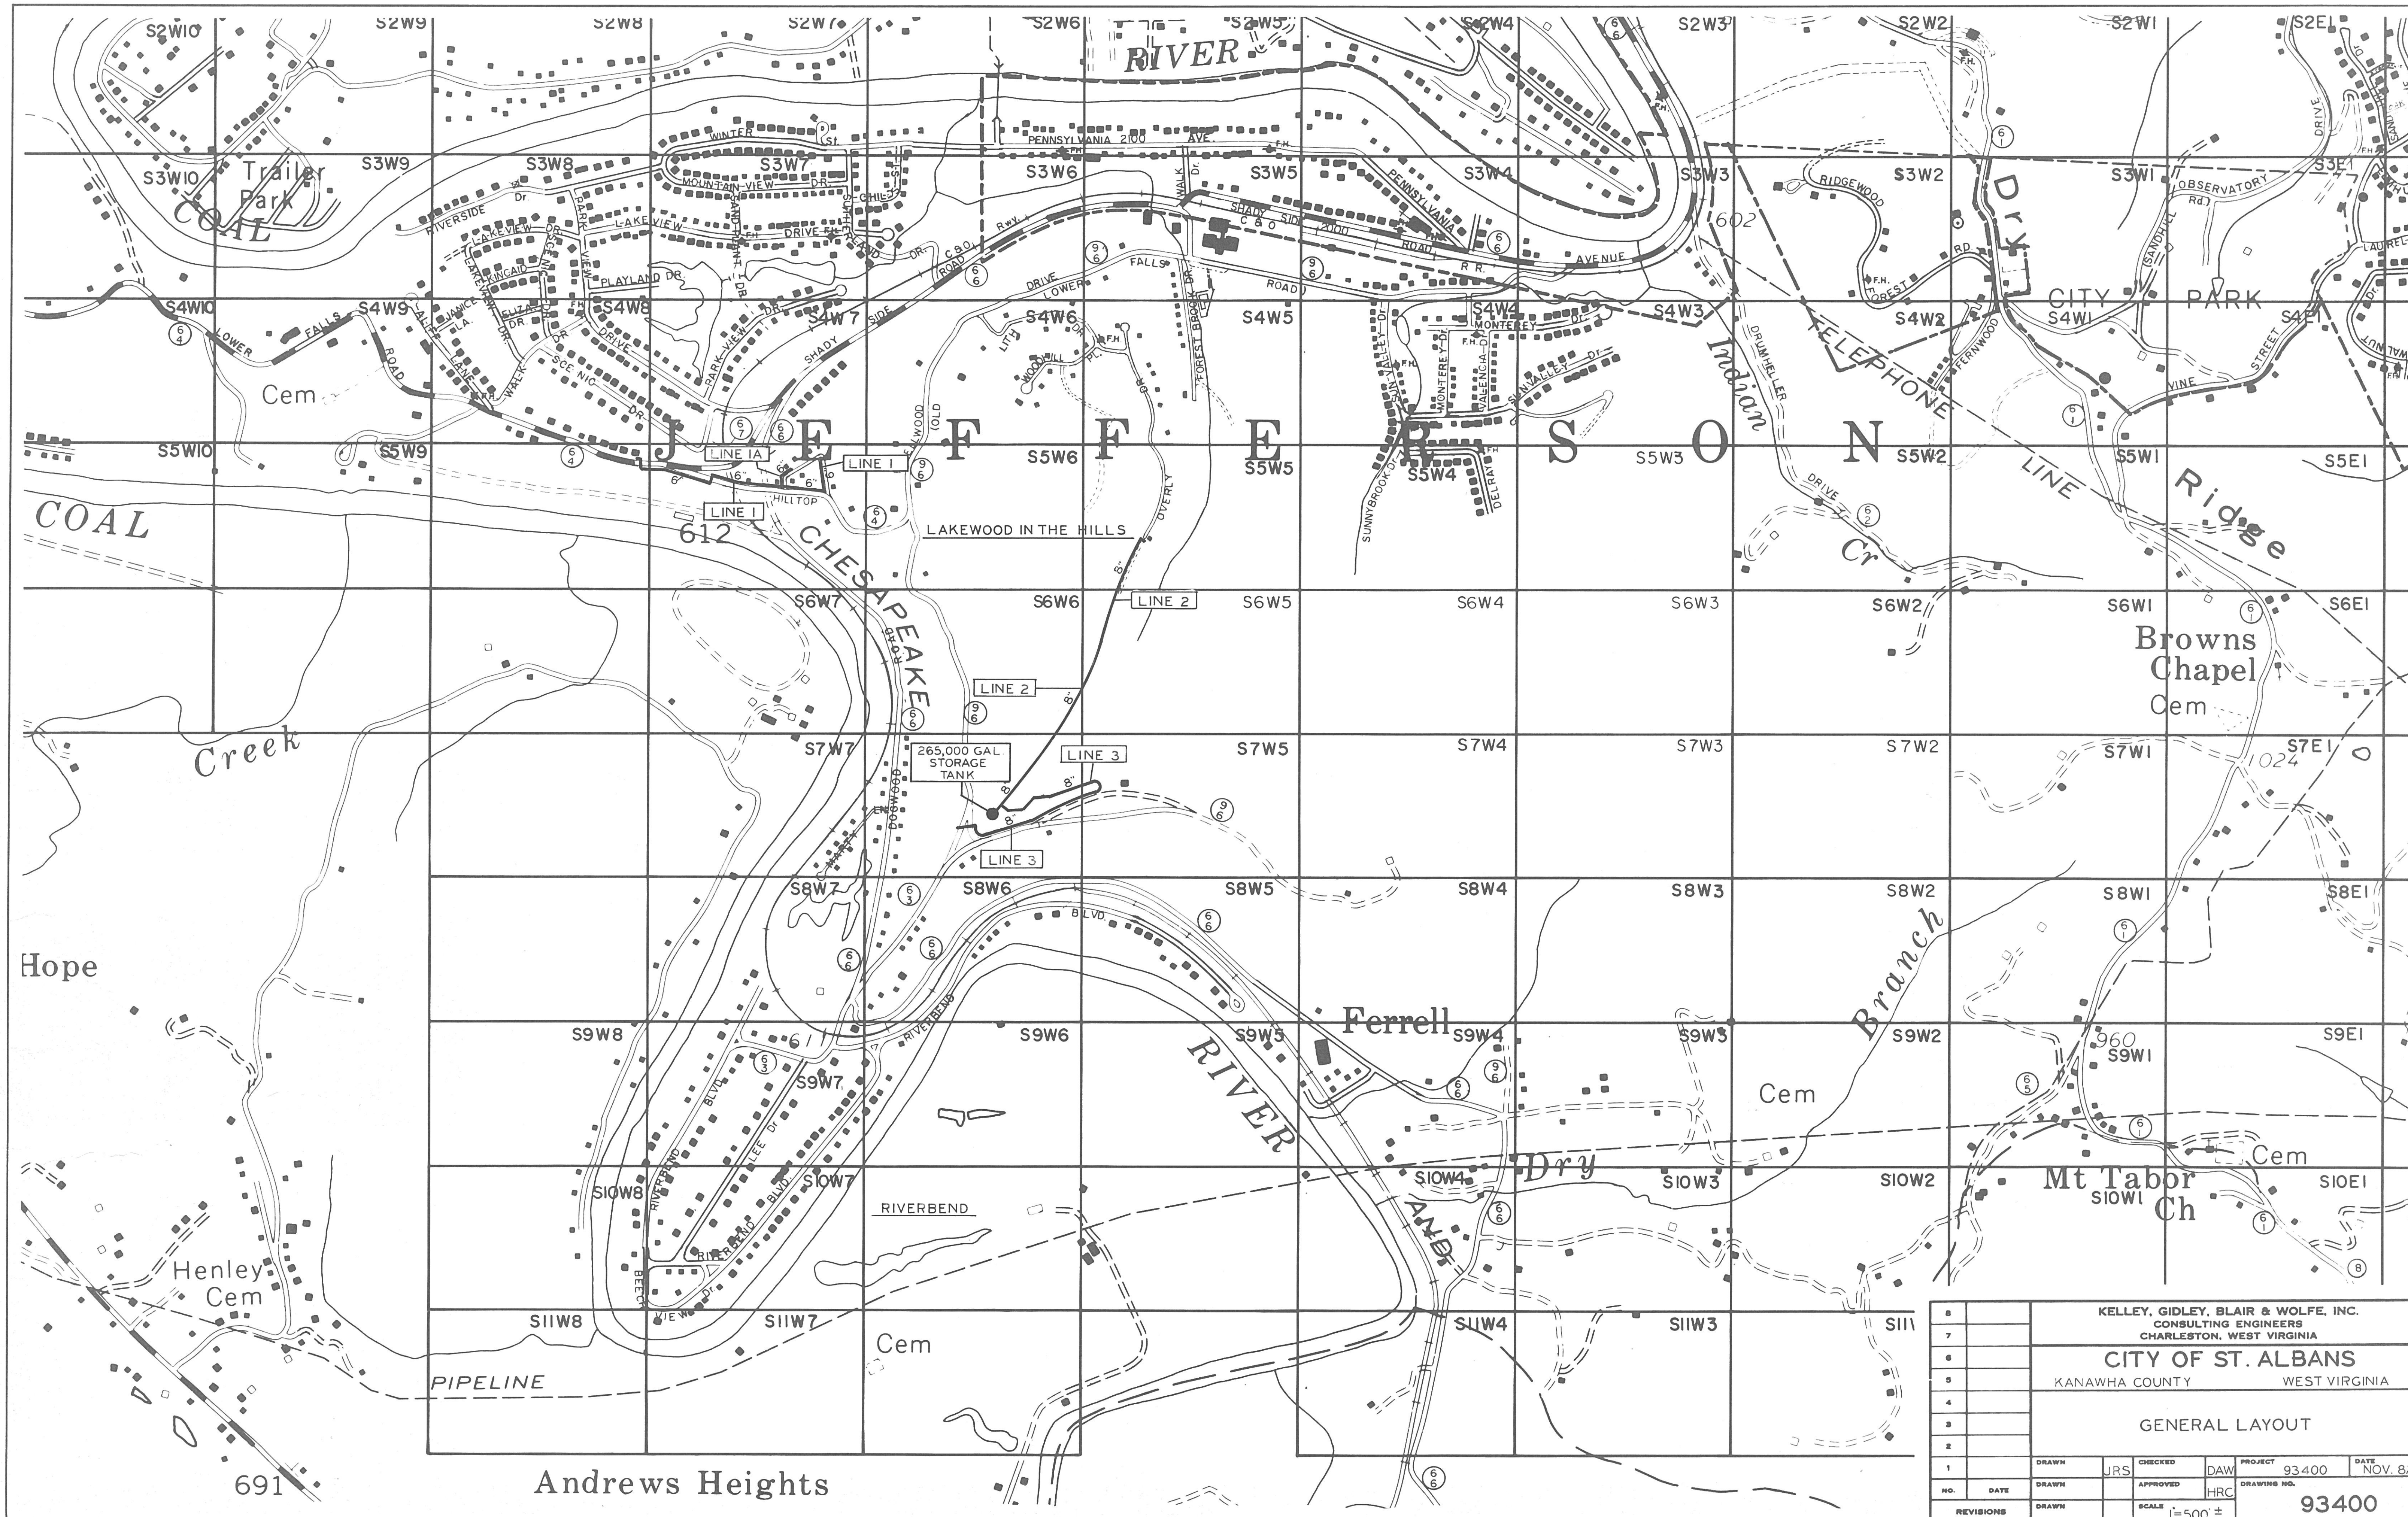

8		KELLEY, GIDLEY, BLAIR & WOLFE, INC.			
7		CONSULTING ENGINEERS			
6		CHARLESTON, WEST VIRGINIA			
5		CITY OF ST. ALBANS			
4		KANAWHA COUNTY		WEST VIRGINIA	
3		GENERAL LAYOUT			
2					
1		DRAWN	JRS	CHECKED	DAW
		DRAWN		APPROVED	HRC
NO.	DATE	SCALE		DRAWING NO.	
REVISIONS		SCALE 1"=500' ±		93400	
				PROJECT 93400 DATE NOV. 82	