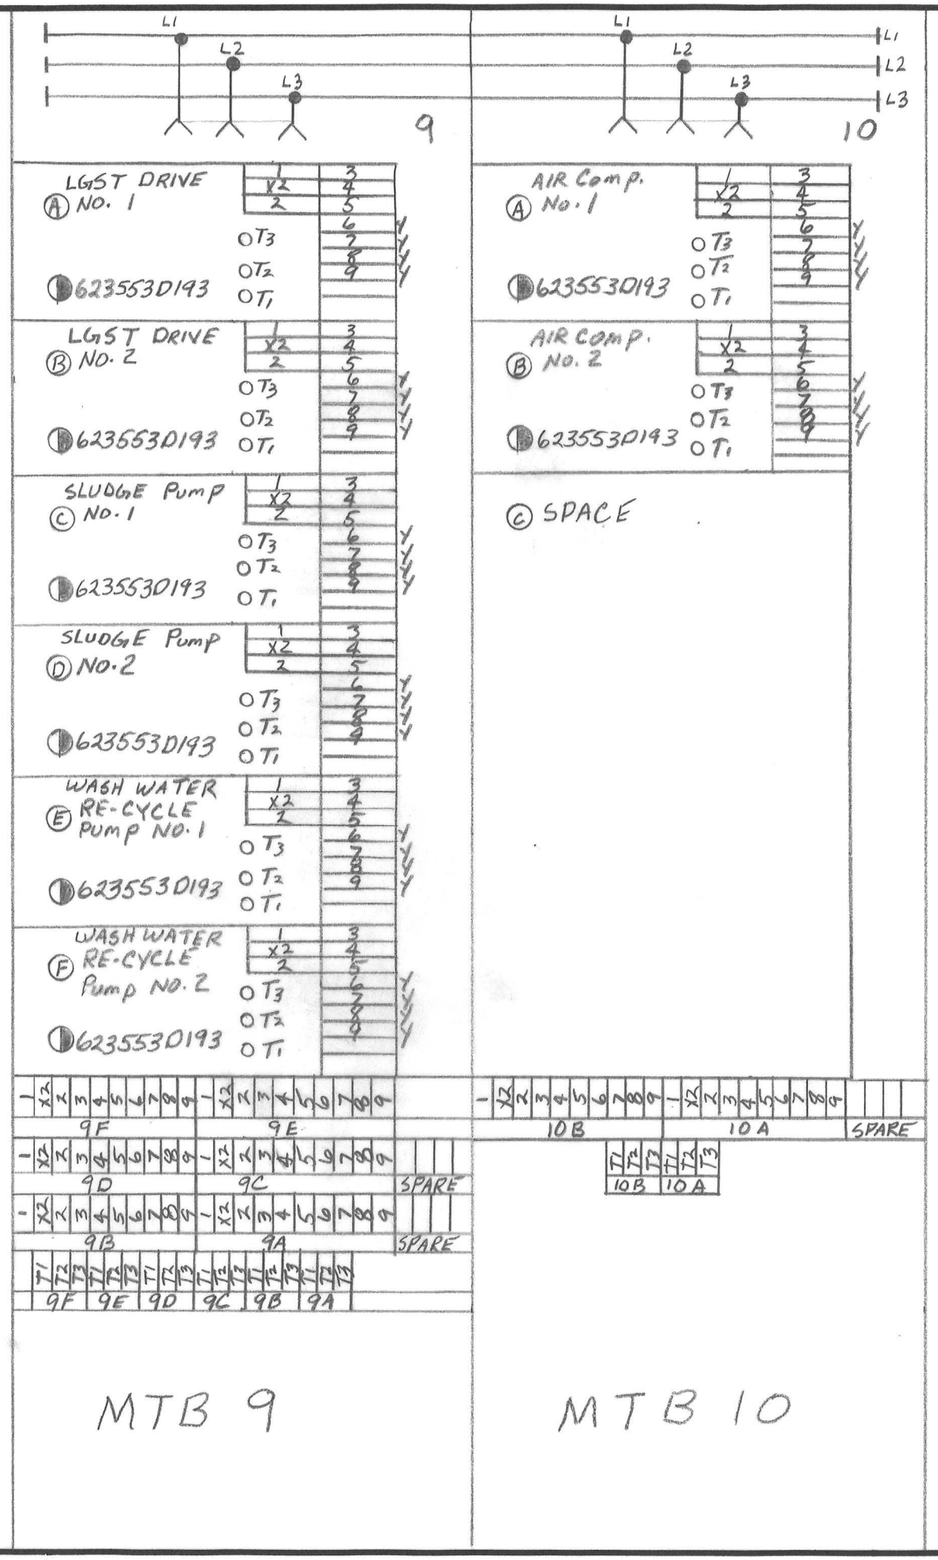

◑ INDICATES UNIT DIAGRAM

DESTINATION CODE: UNIT NO.- TERM. NO.

TOLERANCES (EXCEPT AS NOTED)	REVISIONS					
	NO.	DATE	BY			
DECIMAL ±	1					
	2					
FRACTIONAL ±	3			DRAWN BY BISHOP	SCALE	MATERIAL
ANGULAR ±	4			CHK'D	DATE 10/29	DRAWING NO. 3 OF 9
	5			TRACED	APP'D	

NATIONAL NO. 185E-11X17