


No.	REVISIONS	REFERENCE	PLOTTED	A.F.E. BY
1	Extension of 36" T.C.P.	C.E. Dwg. 5784-N	7-10-23	89
2	Tunnel Warnings	C.E. Dwg. 5784-N	7-10-23	89
3	Change of Line St. Albans to Ferrell	Survey 1916-17, No. 5784	1916	-
4	Siding, Bowman Lumber Co.	Valuation on Auditors Notes	1916	-
5	Changes in Tracks of Old Y.	C.E. Dwg. 6108	7-13-23	89
6	Improvements to Company houses	C.E. Dwg. 6145	1-28-17	3140
7	Monumenting of Right of Way	R. No. 3, 4, 108	12-1-26	-
8	Monumenting of Right of Way	C.E. Dwg. 6492-A	12-1-26	-
9	Left Extension of 18" Cor. Pipe	C.E. Dwg. 6521-A	10-31-91	8136
10	Easement to Ry. A.Va. (Hill) for Road Sta. 31+34	Deed No. 730	2-10-36	-
11	Easements granted for flowage purposes	Kanawha Dist. Deed 925	5-27-38	-
12	Road crossings	Field Notes 1938	9-21-38	-
13	Rail Estate, not house numbers added	C.E. Dwg. F.R. 264	9-27-38	-
14	Land sold to R.V. Wells, Parcel No. 42	Deed No. 741	5-16-39	-
15	Shed on Main St. 7th Ave.	C.E. Dwg. 14305	1-7-41	-
16	Track numbers	Track Record P-265	5-26-42	-
17	Encroachments removed	R.E. File 3886	7-18-42	-
18	Alignment data added	Office Check	1-6-42	-
19	Refine portion of Old M.L. between Sta. 34+45 & 34+80	C.E. Dwg. 14890	12-11-42	15979
20	Property Bowman Lumber Co.	C.E. File 7004	2-12-43	-
21	Monuments set, Parcel No. 27	Info. Dwg. Survey File C-49	4-29-43	-
22	Land sold to S.A.N. Cormick, Parcel No. 5	Deed No. 782	9-27-43	-
23	Land acquired, Chas. W. Ray, Parcel No. 43	Deed No. 786	12-27-43	-
24	Land conveyed to Bowman Lumber Co. Parcel No. 44	Deed No. 785	1-5-44	16105
25	Submerge shanty retired	V.R. 3, 24	4-26-44	-
26	Right of Way Maps set, Parcel No. 43	Cont. File 7206	1-6-46	16076
27	Property sold, Parcel No. 11	Deed No. 796	7-25-45	-
28	Refine portion of storage track	C.E. Dwg. X-12855	0-24-45	16823
29	2nd F. dwelling sold to Richard Knight	V.R. 11, 25, X-12972	12-1-45	17110
30	Property sold, Parcel No. 45 & 46 & 47	C.E. Dwg. X-12105-48	1-14-46	17164-48
31	Property sold, Parcel No. 49 & 50	C.E. Dwg. X-12105-48	2-4-46	17096-17
32	Map retraced	Old Map	3-1-50	-
33	Signal Changes	S.D. 797	1-4-50	17675
34	R.W. Lines Corrected-Parcel 27	Corr. File 410-5	11-9-51	-
35	Prop. Sold - Parcel Nos. 4, 51, & 52	C.E. Dwg. 20806	8-13-52	-
36	Refine 1 S.D. (Gold to A.E. Perry)	C.E. D. 3-15777	1-4-54	20732
37	Parcel No. 53 Sold	C.E. Dwg. 23191-1	8-5-55	-
38	P.B. 5th R.W. Fence-Parcel No. 28	C.E. D. 23797	10-12-55	-
39	Refine Section No. 51+44 on Lt.	V.R. 109, C.E.D. 30717	4-9-59	23891
40	Install 90"-72" Cor. Pipe	C.E. D. 21906-F	3-10-60	24110
41	Don't Granted City for 12" Sewer Access Pans, No. 736-40	C.E.D. 25803; Deed #910	3-12-62	-
42	Don't Granted City for 12" Sewer Access Pans, No. 23303-33	C.E.D. X-17897	5-11-63	-
43	R.V. Perry improvements to High. and Driv.	C.E.D. 24538-A	8-30-64	25470
44	A.B. Portion Washington St. Paved 1/99	C.E.D. 25356-1	5-7-65	24178
45	Refine Trk. #1912 & Relocate PS Trk. #664	C.T.C. & Dwg. #30.424	11-7-66	-
46	Refine Building #19	V.R. 89	4-7-70	-
47	Align Vacated west of 7th St. - See Par. #64	C.E. D. #X-19052	2-3-71	-

KANAWHA COUNTY, W.VA.

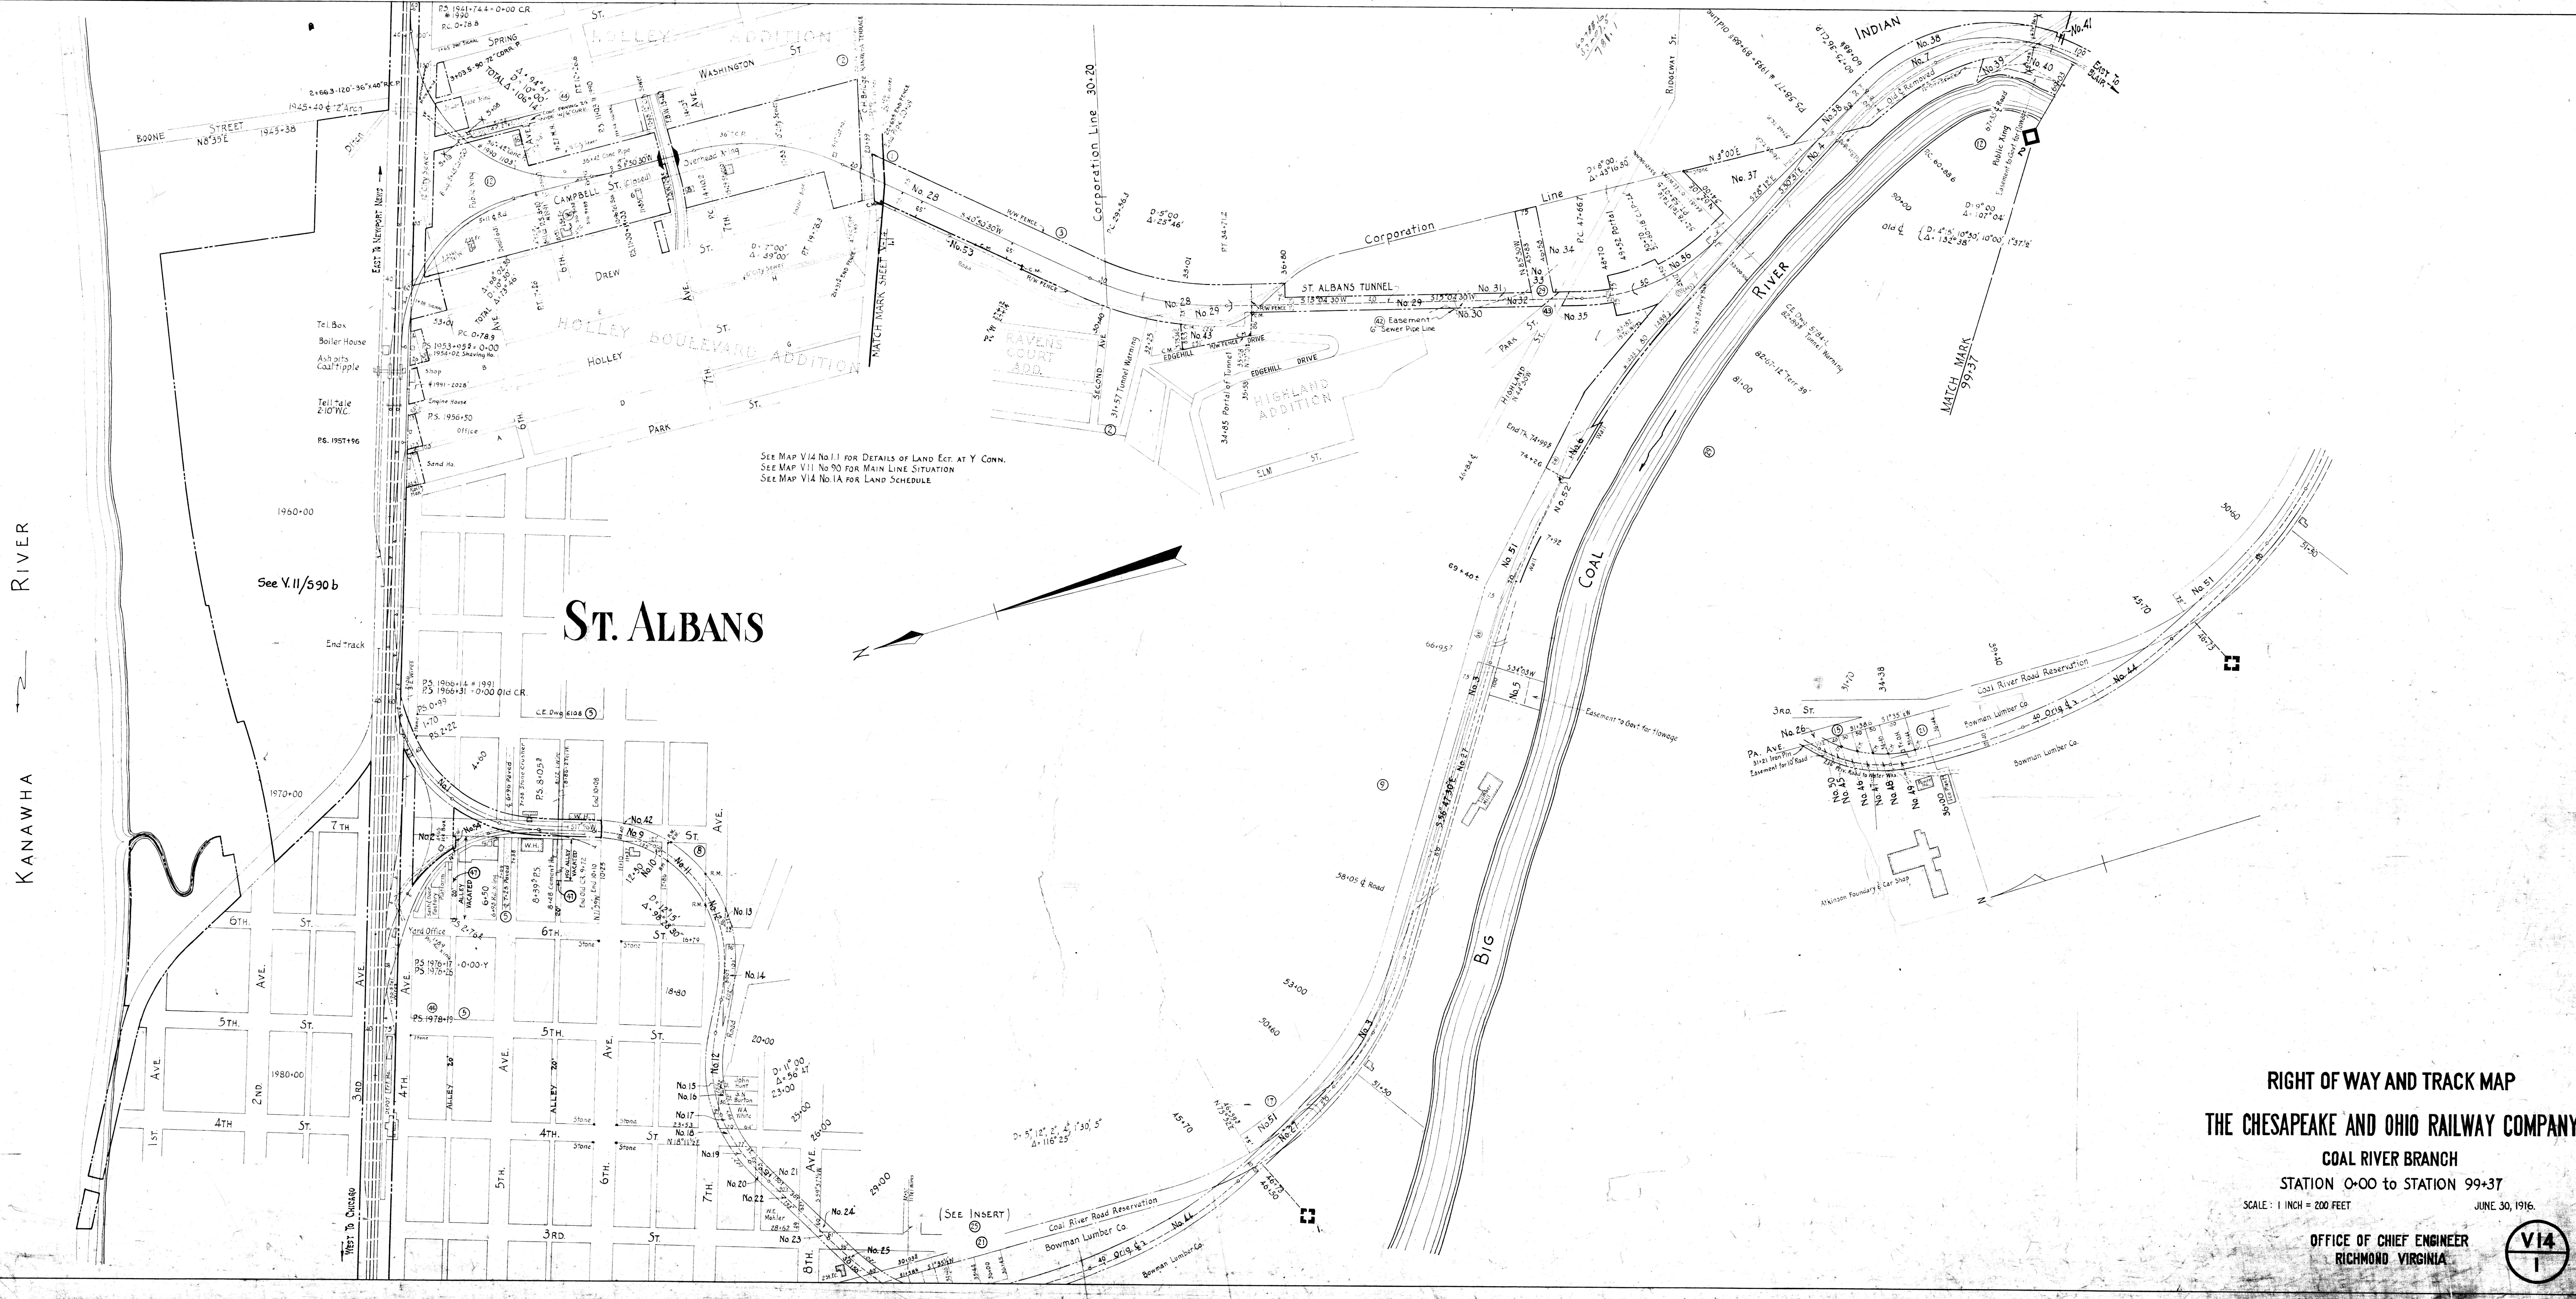

RIGHT OF WAY AND TRACK MAP
 THE CHESAPEAKE AND OHIO RAILWAY COMPANY
 COAL RIVER BRANCH
 STATION 0+00 to STATION 99+37
 SCALE: 1 INCH = 200 FEET
 JUNE 30, 1916
 OFFICE OF CHIEF ENGINEER
 RICHMOND, VIRGINIA

