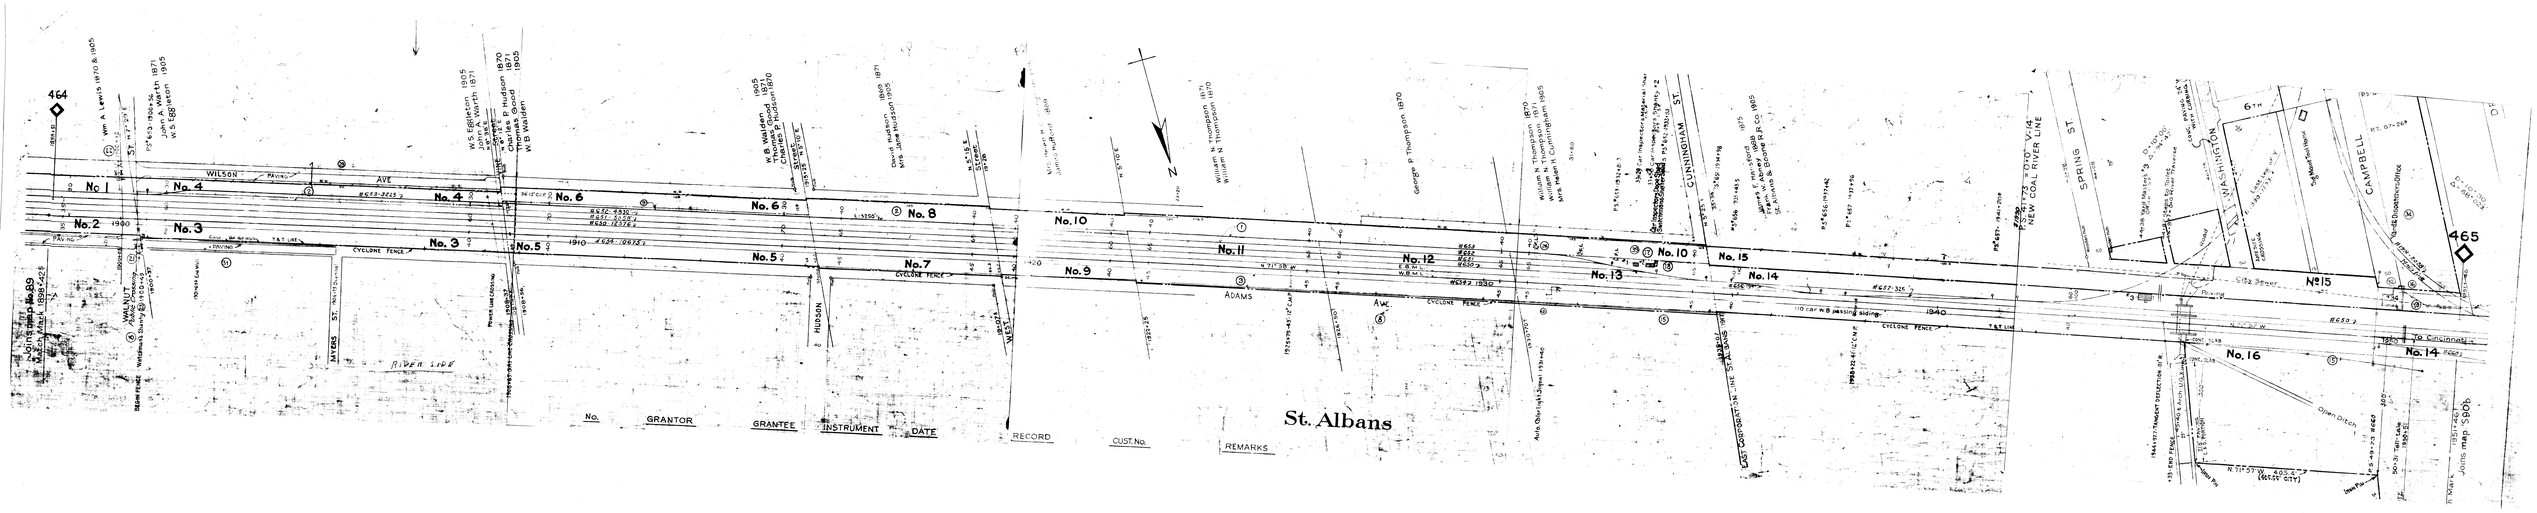
464
465
WILSON AVE
No. 1
No. 2
No. 3
No. 4
No. 5
No. 6
No. 7
No. 8
No. 9
No. 10
No. 11
No. 12
No. 13
No. 14
No. 15
No. 16
CYCLONE FENCE
ADAMS
HUDSON
MYERS ST.
RIVER LINE
CUNNINGHAM ST.
SPRING ST.
WASHINGTON
CAMPBELL
6TH
NEW COAL RIVER LINE
To Cincinnati
Open Ditch
N
St. Albans
No.
GRANTOR
GRANTEE
INSTRUMENT
DATE
RECORD
CUST. No.
REMARKS